

STATE OF KANSAS  
STATE CORPORATION COMMISSION


Form CP-2

WELL PLUGGING RECORD

Give All Information Completely  
Make Required Affidavit  
Mail or Deliver Report to:  
Conservation Division  
State Corporation Commission  
P. O. Box 17027  
Wichita, Kansas 67217  
NORTH

Pawnee County, Sec. 27 Twp. 22S Rge. 20W (E) (W)

Location as "NE/CNW/SW" or footage from lines: C NW SE  
Lease Owner: Beren Corporation  
Lease Name: Dale Well No. #1  
Office Address: 970 Fourth Financial Center, Wichita, Kansas 67202  
Character of Well (completed as Oil, Gas or Dry Hole): dry hole  
Date well completed: January 20, 1980 19  
Application for plugging filed: January 20, 1980 19  
Application for plugging approved: January 20, 1980 19  
Plugging commenced: January 20, 1980 19  
Plugging completed: January 20, 1980 19  
Reason for abandonment of well or producing formation: dry hole

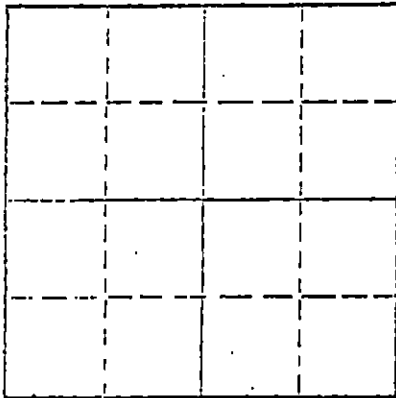

Locate well correctly on above Section Plat

If a producing well is abandoned, date of last production: 19  
Was permission obtained from the Conservation Division or its agents before plugging was commenced? yes

Name of Conservation Agent who supervised plugging of this well: Marion Schmidt  
Producing formation: Depth to top: Bottom: Total Depth of Well: 4461 Feet  
Show depth and thickness of all water, oil and gas formations.

OIL, GAS OR WATER RECORDS

CASING RECORD

FORMATION	CONTENT	FROM	TO	SIZE	PUT IN	PULLED OUT

Describe in detail the manner in which the well was plugged, indicating where the mud fluid was placed and the method or methods used in introducing it into the hole. If cement or other plugs were used, state the character of same and depth placed, from feet to feet for each plug set.

Hole plugged with 50-50 pozmix, 4% gel, as follows: 60 sacks @ 570'  
30 sacks @ 270'; hulls and 10 sacks @ 40'. Job completed @ 4:45 p.m.  
January 20, 1980

STATE OF KANSAS  
FEB 2 1 1980  
2-21-80

(If additional description is necessary, use BACK of this sheet)

Name of Plugging Contractor: Strata Drilling Company  
Address: P. O. Box 355, Great Bend, Kansas 67530


STATE OF KANSAS, COUNTY OF BARTON, ss.

Charles W. Steincamp (employee of owner) or (owner or operator) of the above-described well, being first duly sworn on oath, says: That I have knowledge of the facts, statements, and matters herein contained and the log of the above-described well as filed and that the same are true and correct. So help me God.

(Signature) Charles W. Steincamp

P. O. Box 355, Great Bend, Kansas 67530 (Address)

Subscribed and sworn to before me this 29th day of January, 1980

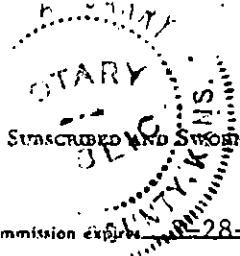

Loneita Barry (Signature)

Notary Public

DRILLERS LOG

#1 Dale

CASING RECORD: 8 jts. new 20# 8-5/8" surface casing	COMPANY: Beren Corporation	DESCRIPTION: C NW SE Section 27-22S-20W Pawnee County, Kansas
TOTAL ROTARY DEPTH: 4461'	CONTRACTOR: Strata Drilling Company	ELEVATION: 2164' KB
	COMMENCED: January 7, 1980	
	COMPLETED: January 20, 1980	

D & A

<u>FORMATION</u>	<u>FROM</u>	<u>TO</u>	<u>REMARKS</u>
Surface soil, shale	0	340	Ran 323' new 20# 8-5/8" surface casing; set and cemented @ 328' with 225 sacks 60-40 pozmix, 2% gel, 3% C.C. Cement circulated. Plug down at 10:00 p.m., January 7, 1980.
Shale, sand	340	1294	
Anhydrite	1294	1320	Ran 10 DST.
Shale	1320	2235	
Lime and shale	2235	2450	Ran 1 electric log.
Lime	2450	2695	
Lime and shale	2695	3825	Hole plugged with 50-50 pozmix, 4% gel, as follows: 60 sacks @ 570', 30 sacks @ 270', hulls and 10 sacks @ 40'. Plugging completed at 4:45 p.m., January 20, 1980.
Lime	3825	3860	
Lime and shale	3860	4100	
Lime	4100	4416	
Mississippi	4416	4461	

STATE OF KANSAS )  
                          ) ss  
COUNTY OF BARTON)

RECEIVED  
 STATE COMMISSION  
 FEB 21 1980  
 CONSERVATION DIVISION  
 TOPEKA, KANSAS

I certify that this is a true and correct copy of the above log to the best of my knowledge.

STRATA DRILLING COMPANY.

Charles W. Steincamp  
Charles W. Steincamp

Sworn to and subscribed before me this 29th day of January, 1980.

My appointment expires 3-28-80.

Loneita Barry  
Loneita Barry, Notary Public

