

STATE OF KANSAS
STATE CORPORATION COMMISSION


WELL PLUGGING RECORD

Give All Information Completely
Make Required Affidavit
Mail or Deliver Report to:
Conservation Division
State Corporation Commission
800 Bitting Building
Wichita, Kansas

OR
FORMATION PLUGGING RECORD Strike out upper line when reporting plugging off formations.

PAWNEE County. Sec. 18 Twp. 22 Rge. 20 (E) 20 (W)

Location as "NE $\frac{1}{4}$ NW $\frac{1}{4}$ SW $\frac{1}{4}$ " or footage from lines. NE NE NE
Lease Owner. Gabbert & Lindas Drilling Co., Inc.
Lease Name. Farrell Well No. 1
Office Address. P.O. Box 112, Great Bend, Kansas
Character of Well (completed as Oil, Gas or Dry Hole). Dry Hole
Date well completed. 1/10/48 19
Application for plugging filed. 1/11/48 19
Application for plugging approved. 19
Plugging commenced. 10:00 A.M. 1/11/48 19
Plugging completed. 1/11/48 19
Reason for abandonment of well or producing formation.

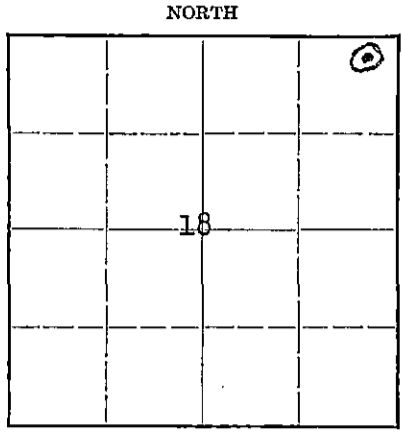

Locate well correctly on above Section Plat

If a producing well is abandoned, date of last production. 19
Was permission obtained from the Conservation Division or its agents before plugging was commenced? Yes

Name of Conservation Agent who supervised plugging of this well. Herb Kerr
Producing formation. 1945 Arbuckle Lime Depth to top. Bottom. Total Depth of Well. 4973 Feet

Show depth and thickness of all water, oil and gas formations.
OIL, GAS OR WATER RECORDS

CASING RECORD

Formation	Content	From	To	Size	Put In	Pulled Out

Describe in detail the manner in which the well was plugged, indicating where the mud fluid was placed and the method or methods used in introducing it into the hold. If cement or other plugs were used, state the character of same and depth placed, from.....feet to.....feet for each plug set.

Filed W/H mud up to 359'. Set wood plug W/H 15 sax cement on plug. Filled up to 25' below cellar. Set wood plug W/H 10 sax cement on plug

1-19-48


(If additional description is necessary, use BACK of this sheet)

Correspondence regarding this well should be addressed to. Gabbert & Lindas Drilling Co., Inc.
Address. 1316 Union National Bank Bldg., Wichita, Kansas

STATE OF Kansas COUNTY OF Sedgwick, ss.
Scott Stucky (employee of owner) or (owner or operator) of the above-described well, being first duly sworn on oath, says: That I have knowledge of the facts, statements, and matters herein contained and the log of the above-described well as filed and that the same are true and correct. So help me God.
(Signature) By Scott Stucky

SUBSCRIBED AND SWORN to before me this 16th day of January, 1948
Catherine Dancy Notary Public.

My commission expires My Commission Expires Mar. 25, 1948

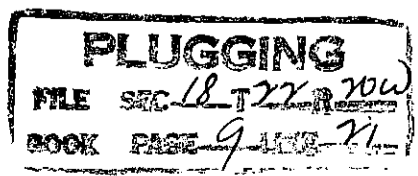

to Corporation Account

January 19, 1948

DRILLING LOG

Lion Oil Company
 Union National Bank Bldg.
 Wichita 2, Kansas

Lease: Farrell #1

County: Pawnee, Kansas

Sec. 18-22-20

Location: NE NE NE

Rotary Total Depth: 4973'

Comm: 12-8-47 Comp: 1-13-48

Shot or Treated

Casing: 8 5/8" @ 1396' 5" None

Contractor: Gabbert & Lindas Drilling Company, Inc.
 1316 Union National Bank Building
 Wichita 2, Kansas

Figures Indicate Bottom of Formations:

0	to	185 Blue Shale & Shells	3325	to	3405 Lime and Shale
185		220 Sand & Gravel	3405		3430 Lime
220		290 Shale Blue	3430		3680 Shale and Lime
290		510 Shale, Sand & Gravel	3680		3735 Lime
510		725 Shale, Lime & Shells	3735		3822 Lime & Shale Breaks
725		735 Shale	3822		3939 Lime and Shale
735		760 Anhydrite	3939		4000 Lime
760		825 Red Rock	4000		4028 Lime & Shale
825		970 Sand	4028		4113 Lime
970		1050 Red Bed & Sand	4113		4138 Lime and Shale
1050		1310 Shale & Shells	4138		4446 Lime
1310		1390 Shale	4446		4684 Shale and Shells
1390		1410 Anhydrite	4684		4500 Lime and Shale
1410		1685 Shale & Shells	4500		4508 Cherty Lime
1685		1710 Shale	4508		4546 Chert
1710		1745 Anhydrite	4546		4570 Cherty Lime, Shale Break
1745		2210 Shale & Shells	4570		4592 Chert
2210		2325 Broken Lime & Shale	4592		4650 Lime
2325		2645 Lime and Shale	4650		4667 Lime Chert
2645		2767 Lime	4667		4720 Lime
2767		2950 Lime and Shale	4720		4753 Lime Chert
2950		3005 Lime	4753		4973 T. D. Lime
3005		3210 Shale and Lime			
3210		3325 Broken Lime			

STATE OF KANSAS)

) SS

COUNTY OF SEDGWICK)

I, the undersigned, being duly sworn on oath state that the above statement and log is true and correct record and log of the well drilled at the location above described.

GABBERT & LINDAS DRILLING COMPANY, INC.

By *Scott Stucky*

Subscribed and sworn to before me
 this 20 day of January, 1947

Mildred Hobbs
 Notary Public

My commission expires Nov. 5, 1951

STATE OF

KANSAS

JAN 22 1948

