

STATE OF KANSAS
STATE CORPORATION COMMISSION

WELL PLUGGING RECORD

Give All Information Completely
Make Required Affidavit
Mail or Deliver Report to
Conservation Division
State Corporation Comm.
245 North Water
Wichita, KS 67202

Pawnee County, Sec. 17 Twp. 22S Rge. 20W E/W
Location as "NE/CNW $\frac{1}{4}$ SW $\frac{1}{4}$ " or footage from lines
NE NW


Lease Owner Sterling Drilling Company
Lease Name Delp #1 Well No. 1
Office Address P. O. Box 129, Sterling, Kansas 67579
Character of Well (Completed as Oil, Gas or Dry Hole)
Dry Hole

Date Well completed May 19, 1977 19
Application for plugging filed May 19, 1977 19
Application for plugging approved May 19, 1977 19
Plugging commenced 9:00 PM, May 19, 1977 19
Plugging completed 11:00 PM, May 19, 1977 19
Reason for abandonment of well or producing formation
Dry Hole

If a producing well is abandoned, date of last production 19

Was permission obtained from the Conservation Division or its agents before plugging was commenced? Yes

Name of Conservation Agent who supervised plugging of this well Leo F. Massey
Producing formation _____ Depth to top _____ Bottom _____ Total Depth of Well 4560'
Show depth and thickness of all water, oil and gas formations.

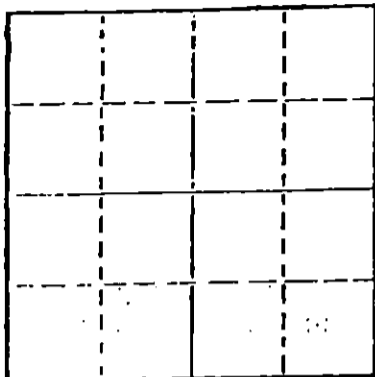

Locate well correctly on above Section Plot

OIL, GAS OR WATER RECORDS

CASING RECORD

FORMATION	CONTENT	FROM	TO	SIZE	PUT IN	PULLED OUT
				8 5/8"	301'	None

Describe in detail the manner in which the well was plugged, indicating where the mud fluid was placed and the method or methods used in introducing it into the hold. If cement or other plugs were used, state the character of same and depth placed, from _____ feet to _____ feet for each plug set.

RECEIVED
STATE CORPORATION COMMISSION
MAY 23 1977
Filled hole with heavy mud.
50 sacks Pozmix at 40';
25 sacks at 240'; 1/2 sack Hulls and
Plug to make Bridge and 10 sacks - 40' to
surface; 2 sacks in rathole.

CONSERVATION DIVISION
Wichita, Kansas

5-23-77

(If additional description is necessary, use BACK of this sheet)

Name of Plugging Contractor Sterling Drilling Company, P. O. Box 129, Sterling, Kansas 67579

STATE OF KANSAS COUNTY OF RICE, ss.
F. A. Wuellner (employee of owner) or (owner or operator)
of the above-described well, being first duly sworn on oath, says: That I have knowledge of the facts, statements, and matters herein contained and the log of the above-described well as filed and that the same are true and correct. So help me God. STERLING DRILLING COMPANY


(Signature) *F. A. Wuellner*
F. A. Wuellner, Secretary
P. O. Box 129, Sterling, Kansas 67579
(Address)

SUBSCRIBED AND SWORN TO before me this 20th day of May, 1977

Charles M. Hall

CHARLES HALL—NOTARY PUBLIC
My commission expires My Commission Expires Jan. 6, 1978

Charles M. Hall, Notary Public.

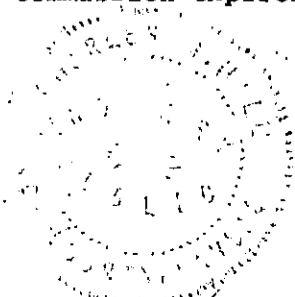

STERLING DRILLING COMPANY
P. O. Box 129
Sterling, Kansas 67579

WELL LOG ----- DELP #1

Located: NE NW, Section 17-22S-20W, Pawnee County, Kansas

OWNER: Sterling Drilling Company, et al
ROTARY DRILLING CONTRACTOR: Sterling Drilling Company

COMMENCED: May 10, 1977
COMPLETED: May 19, 1977

TOTAL DEPTH: 4560'

<u>LOG</u>		<u>CASING RECORD</u>
0 - 305	Clay and Shale	Ran 7 joints 8 5/8" casing, 289.42' set at 301' K.B. Cemented with 200 sacks Pozmix, 3% cc. Plug down at 2:00 AM, 5-11-77.
305 - 1393	Shale	
1393 - 1430	Anhydrite - Lime	
1430 - 4255	Lime and Shale	
4255 - 4360	Lime	
4360 - 4455	Lime and Shale	
4455 - 4500	Lime	
4500 - 4510	Lime and Shale	
4510 - 4525	Lime	
4525 - 4560	Lime and Shale	Plugged.

RECEIVED
STATE OF KANSAS COMMISSION

MAY 23 1977

CONSERVATION DIVISION
Wichita, Kansas