


WELL PLUGGING RECORD

Give All Information Completely
Make Required Affidavit
Mail or Deliver Report to:
Conservation Division
State Corporation Commission
212 North Market, Insurance Bldg.
Wichita, Kansas

Stafford County, Sec. 30 Twp. 23 Rge. 12 (X) (W)
Location as "NE/CNW%SW%" or footage from lines SE SE NW
Lease Owner Dunne-Gardner Drilling Co., Inc.
Lease Name Fischer Well No. 1
Office Address 300 Schweiter Bldg., Wichita 2, Kansas
Character of Well (completed as Oil, Gas or Dry Hole) Dry Hole
Date well completed February 23 19 59
Application for plugging filed " 23 19 59
Application for plugging approved " 23 19 59
Plugging commenced " 23 19 59
Plugging completed " 23 19 59
Reason for abandonment of well or producing formation _____

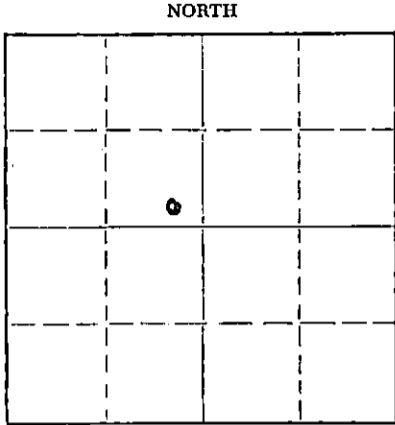

Locate well correctly on above Section Plat

If a producing well is abandoned, date of last production _____ 19 ____
Was permission obtained from the Conservation Division or its agents before plugging was commenced? Yes

Name of Conservation Agent who supervised plugging of this well Mr. Frank Broadfoot
Producing formation _____ Depth to top _____ Bottom _____ Total Depth of Well 3960 Feet
Show depth and thickness of all water, oil and gas formations.

OIL, GAS OR WATER RECORDS

CASING RECORD

FORMATION	CONTENT	FROM	TO	SIZE	PUT IN	PULLED OUT
Surface Pipe		0	267'	8 5/8	2-11-59	

Describe in detail the manner in which the well was plugged, indicating where the mud fluid was placed and the method or methods used in introducing it into the hole. If cement or other plugs were used, state the character of same and depth placed, from _____ feet to _____ feet for each plug set.

Fill hole with heavy drilling mud to 240' from top - put in plug, 20 sacks cement and 1/2 sack of hulls. Fill hole to within 40' of top with heavy mud - put in second plug, 1/2 sack of hulls and 10 sacks of cement.

RECEIVED
STATE CORPORATION COMMISSION
MAR 24 1959
CONSERVATION DIVISION
Wichita, Kansas

(If additional description is necessary, use BACK of this sheet)

Name of Plugging Contractor _____
Address _____

STATE OF Kansas, COUNTY OF Sedgwick, ss.
Don Gardner (owner or operator) of the above-described well, being first duly sworn on oath, says: That I have knowledge of the facts, statements, and matters herein contained and the log of the above-described well as filed and that the same are true and correct. So help me God.

(Signature) [Signature]
300 Schweiter Bldg., Wichita 2, Kansas
(Address)

SUBSCRIBED AND SWORN TO before me this 24th day of February, 19 59

Helen L. Hodgson
Notary Public.

My commission expires 11-3-60

PLUGGING
FILE SEC. 30 T. 23 R. 12 W
BOOK PAGE 16 LINE 30

DRILLER'S LOG

15-185-00353-0000

Company: Dunne-Gardner Drilling Co., Inc.
 300 Schweiter Building
 Wichita 2, Kansas

Lease: Fischer

Well: No. 1

Location: SE SE NW of Section 30, Township 23 South,
 Range 12 West, Stafford County, Kansas

Date Comm: February 10, 1959

Date Compl: February 23, 1959

T.D.: 3960 Feet

Casing: 267' - 8 5/8" Surface Casing w/190 Sacks Cement.

From	To	
0	35	Shale
35	48	Sand
48	210	Shale
210	225	Sand
225	260	Shale & Shells
260	702	Red Bed & Shells
702	729	Anhydrite
729	740	Shale
740	1215	Shale & Shells
1215	1610	Shale & Lime
1610	1770	Lime & Shale
1770	1812	Shale & Shells
1812	1930	Lime
1930	2560	Lime & Shale
2560	3160	Shale & Lime
3160	3446	Lime & Shale
3446	3722	Lime
3722	3740	Lime & Shale
3740	3763	Conglomerate
3763	3780	Chert
3780	3820	Chert & Lime
3820	3850	Chert & Shale
3850	3880	Lime
3880	3905	Shale & Sand
3905	3912	Sand
3912	3944	Shale & Sand
3944	3960	Lime
	3960	T. D.
		D&A

RECEIVED
 STATE CORPORATE COMMISSION
 MAR 24 1959
 CONSERVATION DIVISION
 Wichita, Kansas

I certify the above to be true and correct to the best of my knowledge and belief.

DUNNE-GARDNER DRILLING CO., INC.

By Don Gardner
 Don Gardner

Subscribed and sworn before me this 24th day of February, 1959.

Helen L. Hodgson
 Notary Public

My Commission Expires:

11-3-60

PLUGGING
 FILE SEC. 30 T. 23 R. 12 W
 BOOK PAGE 16 LINE 30