


69

Give All Information Completely
Make Required Affidavit
Mail or Deliver Report to:
Conservation Division
State Corporation Commission
811 No. Broadway
Wichita, Kansas

WELL PLUGGING RECORD

15-185-30012-0000

NORTH

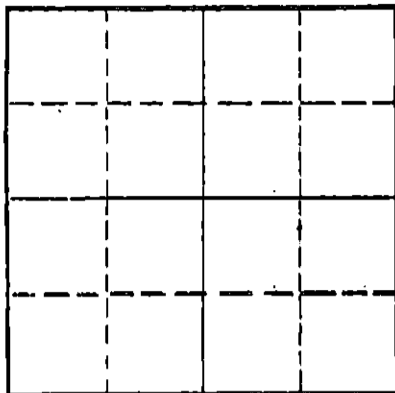

Locate well correctly on above
Section Plot

Stafford County, Sec. 32 Twp. 23S Rge. 12X (SE) (W)
Location as "NE/CNW/SW" or footage from lines SE SE NE
Lease Owner Martin & Keller
Lease Name Parks Well No. 1
Office Address 1035 Kennedy Building
Character of Well (completed as Oil, Gas or Dry Hole) Dry Hole
Date well completed 2-1-65 10
Application for plugging filed 2-1-65 10
Application for plugging approved 2-1-65 10
Plugging commenced 2-1-65 10
Plugging completed 2-1-65 10
Reason for abandonment of well or producing formation Dry Hole

If a producing well is abandoned, date of last production 10
Was permission obtained from the Conservation Division or its agents before plugging was commenced? yes

Name of Conservation Agent who supervised plugging of this well Archie Elving, Pratt, Kansas
Producing formation _____ Depth to top _____ Bottom _____ Total Depth of Well 3950 Feet
Show depth and thickness of all water, oil and gas formations.

OIL, GAS OR WATER RECORDS

CASING RECORD

FORMATION	CONTENT	FROM	TO	SIZE	PU. IN	PULLED OUT
				8 5/8"	317'	none

Describe in detail the manner in which the well was plugged, indicating where the mud fluid was placed and the method or methods used in introducing it into the hole. If cement or other plugs were used, state the character of same and depth placed, from _____ feet to _____ feet for each plug set.

Mud to 250' 1/2 sk. hulls plug with 25 sacks cement
Mud to 40' 1/2 sk. hulls plug with 10 sacks cement
2 sacks in rathole.

RECEIVED
STATE CORPORATION COMMISSION

FEB 11 1965
2-11-65

CONSERVATION DIVISION
Wichita, Kansas

(If additional description is necessary, use BACK of this sheet)

Name of Plugging Contractor Leben Drilling, Inc.
Address Box 486, Great Bend, Kansas

STATE OF KANSAS, COUNTY OF BARTON, KS.
Leslie Kite (employee of owner) or (owner or operator) of the above-described well, being first duly sworn on oath, says: That I have knowledge of the facts, statements, and matters herein contained and the log of the above-described well as filed and that the same are true and correct. So help me God.

(Signature) Leslie Kite
Box 486, Great Bend, Kansas
(Address)

Subscribed and sworn to before me this 4th day of Feb., 1965

Claude D. [Signature]
Notary Public

My commission expires April 1, 1967