

**Give All Information Completely
Make Required Affidavit
Mail or Deliver Report to:
Conservation Division
State Corporation Commission,
800 Bittling Building,
Wichita, Kansas**

Strike out upper line when reporting plugging off formations.

Rec'd
12-1-36

15-185-61628-0000

A 4x4 grid with handwritten numbers 3 and 9 in the center, and a small cross-like symbol in the bottom-left corner.

Locate well correctly on above
Section Plat

Name of Conservation Agent who supervised plugging of this well..... C. T. Alexander

Producing formation..... Depth to top..... Bottom..... Total Depth of Well..... 3985


Show depth and thickness of all water, oil and gas formations.

CASING RECORD

[illegible]

Describe in detail the manner in which the well was plugged, indicating where the mud fluid was placed and the method or methods used in introducing it into the hole. If cement or other plugs were used, state the character of same and depth placed, from _____ feet to _____ feet for each plug set.

Hole filled with mud laden fluid (12 $\frac{1}{2}$ %) to within 200 feet of top, at which point wood plug was placed with 30 sacks of cement on top thereof. Surface hole was then filled with mud laden fluid to within 20 feet of top, at which point hole was bridged and remainder of hole filled with cement.

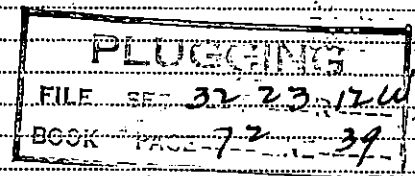

(If additional description is necessary use BACK of this sheet)

Correspondence regarding this well should be addressed to The Atlantic Refining Company
Address Box 17, Great Bend, Kansas.

STATE OF Kansas, COUNTY OF Barton, ss.
Dewey A. Jordan (employee of owner) or (owner or agent)

Dewey A. Jordan (employee of owner) or (owner or operator) of the above-described well, being first duly sworn on oath, says: That I have knowledge of the facts, statements, and matters herein contained and the log of the above-described well as filed and that the same are true and correct. So help me God.

(Signature)

Box 17, Great Bend, Kansas.
(Address)

(Address)

SUBSCRIBED AND SWORN to before me this 12 day of December, 1936.

My commission expires.

16-1484

11-26-5M

.....
Notary Public.

FORMATION	TOP	BOTTOM	FORMATION	TOP	BOTTOM
Cellar	0	11	Lime	2519	2555
Clay	11	20	Shale	2555	2644
Sand	20	30	Lime	2644	2697
Clay	30	40	Shale	2697	2708
Sand	40	50	Lime	2708	2730
Clay	50	70	Shale	2730	2738
Sand	70	80	Lime	2738	2758
Shale	80	90	Shale	2758	2768
Sand	90	100	Lime	2768	2780
Shale	100	125	Shale	2780	2790
Sand and shale	125	130	Lime	2790	2815
Shale	130	170	Broken lime	2815	2828
Sand	170	185	Shale	2828	2843
Shale	185	235	Lime	2843	2850
Red bed	235	267	Shale	2850	2860
Reamed to 17-1/4	0	253	Lime	2860	2889
Plug and cement	237	245	Broken lime	2889	2894
Open hole	245	265	Lime	2894	2910
Lime shells and shale	265	285	Shale	2910	2955
Sand	285	295	Lime	2955	2958
Shale	295	390	Broken lime	2958	2978
Red beds	390	605	Shale	2978	2985
Red bed shale	605	645	Lime	2985	3004
Broken lime	645	659	Broken lime	3004	3012
Shale	659	677	Lime	3012	3033
Lime	677	720	Broken lime and shale	3033	3045
Shale	720	808	Lime	3045	3051
Shale and gyp	808	920	Broken lime and shale	3051	3070
Shale and lime shells	920	1019	Lime	3070	3090
Sandy lime and shale	1019	1055	Shale	3090	3137
Anhydrite	1055	1065	Lime	3137	3145
Shale	1065	1090	Shale	3145	3156
Anhydrite shells	1090	1150	Lime	3156	3164
Shale	1150	1180	Shale	3164	3183
Salt and shale	1180	1230	Broken lime	3183	3227
Shale and shells	1230	1271	Broken lime and shale	3227	3253
Shale	1271	1360	Shale	3253	3270
Lime	1360	1368	Lime	3270	3288
Shale	1368	1437	Broken lime	3288	3290
Lime	1437	1442	Lime	3290	3300
Shale	1442	1505	Shale	3300	3310
Lime	1505	1517	Lime	3310	3320
Shale	1517	1548	Shale and shells	3320	3493
Lime	1548	1590	Broken lime and shale	3493	3503
Lime and gyp	1590	1635	Lime	3503	3536
Lime	1634	1670	Broken lime and shale	3536	3545
Shale	1670	1672	Lime	3545	3582
Lime	1672	1680	Shale	3582	3587
Shale	1680	1698	Lime	3587	3610
Lime	1698	1700	Lime K.C.	3610	3667
Broken lime	1700	1725	Broken lime	3667	3710
Anhydrite	1725	1760	Shale	3710	3744
Lime and shale	1760	1800	Chat	3744	3752
Lime	1800	1830	Lime and chert	3752	3774
Broken lime and shale	1830	1834	Shale	3774	3776
Lime	1834	1848			
Broken lime and shale	1848	1861	Broken chert, lime and		
Shale	1861	1880	shale	3776	3815
Lime	1880	1961	Chert and lime	3815	3850
Sand	1961	1989			
Stacky shale	1989	2043			
Shale and lime shells	2043	2065			
Lime	2065	2073			
Broken lime and shale	2073	2096			
Broken lime	2096	2145			
Broken lime and shale	2145	2181			
Shale	2181	2210			
Lime	2210	2240			
Shale	2240	2276			
Broken lime	2276	2304			
Shale	2304	2322			
Lime	2322	2340			
Broken lime and shale	2340	2363			
Lime	2363	2377			
Broken lime and shale	2377	2383			
Lime	2383	2400			
Shale	2400	2434			
Lime	2434	2445			
Shale	2445	2465			
Broken lime and shale	2465	2519			