

5-185-016 30000

WELL PLUGGING RECORD

Give All Information Completely
Make Required Affidavit
Mail or Deliver Report to:
Conservation Division
State Corporation Commission
800 Bittling Building
Wichita, Kansas

STAFFORD

County. Sec. 33 Twp. 23 Rge. 12 (W)

Location as "NE/CNW $\frac{1}{4}$ /SW $\frac{1}{4}$ " or footage from lines NE NE NE

Lease Owner Leben & Fisher,

Lease Name Jimison Well No. 1

Office Address El Dorado, Kansas

Character of Well (completed as Oil, Gas or Dry Hole) Dry Hole

Date well completed Jan 7th 19 51

Application for plugging filed Jan 8th 19 51

Application for plugging approved Jan 9th 19 51


Plugging commenced Jan 7th 19 51

Plugging completed Jan 7th 19 51

Reason for abandonment of well or producing formation DRY HOLE

If a producing well is abandoned, date of last production 19

Was permission obtained from the Conservation Division or its agents before plugging was commenced? YES

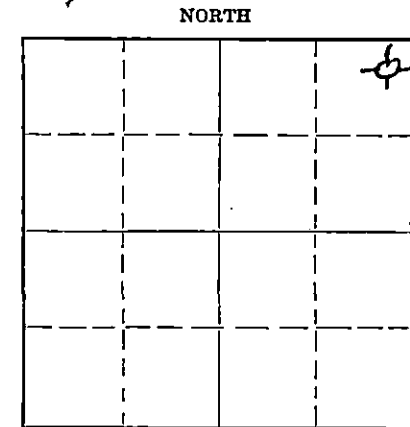

Locate well correctly on above Section Flat

Name of Conservation Agent who supervised plugging of this well C. D. STOUGH

Producing formation Depth to top Bottom Total Depth of Well 3880 Feet

Show depth and thickness of all water, oil and gas formations.

OIL, GAS OR WATER RECORDS

CASING RECORD

Formation	Content	From	To	Size	Put In	Pulled Out
	SURFACE			8 5/8"	199'	NONE

Describe in detail the manner in which the well was plugged, indicating where the mud fluid was placed and the method or methods used in introducing it into the hole. If cement or other plugs were used, state the character of same and depth placed, from feet to feet for each plug set.

Loaded hole with mud; Set first plug at 196' spotted 15 sax cement thru drill pipe; Set second plug at 30 feet, spotted 10 sax cement, loaded hole between plugs with mud.

(If additional description is necessary, use BACK of this sheet)

Correspondence regarding this well should be addressed to Raymond & Lebow Drilling Co.
Address 202 Bissantz Bldg., Wichita, Kansas

STATE OF KANSAS, COUNTY OF SEDGWICK, ss.

Chas. W. Raymond, Supt (employee of owner) or (owner or operator) of the above-described well, being first duly sworn on oath, says: That I have knowledge of the facts, statements, and matters herein contained and the log of the above-described well as filed and that the same are true and correct. So help me God. RAYMOND & LEBOW DRILLING CO.

(Signature) BY Chas. W. Raymond
SUPERINTENDENT
202 Bissantz Bldg., Wichita Kansas
(Address)

SUBSCRIBED AND SWORN to before me this 11th day of January 1951

RECEIVED
STATE CORPORATION COMMISSION
[Signature]
Notary Public

My commission expires MAY-18-1952

28-3273-s 4-50-10M

JAN 13 1951
CONSERVATION DIVISION
Wichita, Kansas

PLUGGING
FILE SEC 33T 23R 12W
BOOK PAGE 54 LINE 3

1-13-51

Lebon & Fisher
El Dorado, Kansas

NE NE NE, 33-23S-12W
Stafford County, Kansas

Jimison #1

15-185-01630-0000

Conn. 12-20-50
Comp. 1-7-51

Total Depth 3880'

Casg. 8 - 5/8

196' Cemented.

Cellar	0	5
Sand Clay & Gravel	5	189
Redbed	189	196
Redbed	196	270
Redbed & Shells	270	663
Anhydrite	663	687
Shale & Shells	687	960
Shales & Shells	960	1050
Salt	1050	1330
Shale & Shells	1330	1370
Shale & Lime Shells	1370	1510
Shale & Lime	1510	1730
Lime & Shale	1730	1890
Shale & Lime	1890	2110
Shale & Lime	2110	2575
Lime & Shale	2575	2910
Lime & Shale	2910	3160
Lime & Shale	3160	3360
Shale & Lime	3360	3416
Lime & Shale	3416	3455
Lime	3455	3457
Lime	3457	3555
Lime & Shale	3555	3611
Lime	3611	3730
Lime (cherty)	3730	3785
Lime & Shale	3785	3870
TOTAL DEPTH	3880'	

I hereby certify that this is a true and correct log of the above described well as shown by the drilling reports.

RAYMOND & LEBOW DRILLING COMPANY, INC.

BY

RECEIVED
STATE CORPORATION COMMISSION
MAR - 5 1951
CONSERVATION DIVISION
Wichita, Kansas

Leben & Fisher
Eldorado, Kansas

NE-NE-NE, 33-23S-12W
Stafford County, Kansas

Jimison

Conn. 12-20-50
Comp. 1-7-51

15-185-01630-0000

Total Depth 3880'

Gasg. 8- 5/8

199' Cemented

Cellar	0	5
Sand Clay & Gravel	5	189
Redbed	189	196
Redbed	196	270
Red Bed & Shells	270	663
Anhydrite	663	687
Shale & Shells	687	810
Shale & Shells	810	960
Shales & Shells	960	1050
Salt	1050	1330
Shale & Shells	1330	1370
Shale & Lime Shells	1370	1510
Shale & Lime	1510	1730
Lime & Shale	1730	1890
Shale & Lime	1890	2110
Shale & Lime	2110	2575
Lime & Shale	2575	2910
Lime & Shale	2910	3160
Lime & Shale	3160	3360
Shale & Lime	3360	3416
Lime & Shale	3416	3455
Lime	3455	3457
Lime	3457	3555
Lime & Shale	3555	3611
Lime	3611	3730
Lime (cherty)	3730	3785
Lime & Shale	3785	3870
<u>Total Depth</u>	<u>3870</u>	<u>3880</u>

I hereby certify that this is a true and correct log of the above described well as shown by the drilling reports.

RAYMOND & LEBOW DRILLING COMPANY, INC.

BY

Chas W Raymond

STATE OF KANSAS)
) SS.
COUNTY OF SEDGWICK)

Subscribed and sworn to before me, a Notary Public, in and for said County and State, this 17th day of July, 1951.

Yencuethy
Notary Public

My Commission Expires May 18-1952

PLUGGING
FILE SEC 32T 23R 1X
BOOK PAGE 54 LINE 3

RECEIVED
STATE CORPORATION COMMISSION
JAN 13 1951
CONSERVATION DIVISION
Wichita, Kansas