


Give All Information Completely  
Make Required Affidavit  
Mail or Deliver Report to:  
Conservation Division  
State Corporation Commission  
212 North Market, Insurance Bldg.  
Wichita, Kansas

*Rec'd  
2-1-60*

WELL PLUGGING RECORD

Stafford County. Sec. 34 Twp. 23 Rge. 12 (E) (W)

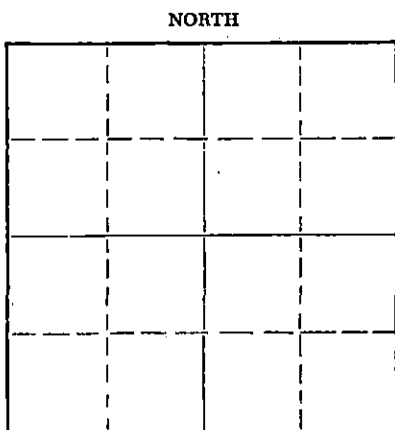

Locate well correctly on above Section Plat

Location as "NE/CNW/SW" or footage from lines SW-SW-NW  
Lease Owner WILKINSON DRILLING, INC.  
Lease Name Verning Well No. 1  
Office Address 1121 Union National Building, Wichita 2, Kansas  
Character of Well (completed as Oil, Gas or Dry Hole) Dry Hole  
Date well completed January 20, 19 60  
Application for plugging filed January 20, 19 60  
Application for plugging approved January 20, 19 60  
Plugging commenced January 20, 19 60  
Plugging completed January 20, 19 60  
Reason for abandonment of well or producing formation Dry Hole

If a producing well is abandoned, date of last production \_\_\_\_\_ 19\_\_\_\_  
Was permission obtained from the Conservation Division or its agents before plugging was commenced? yes

Name of Conservation Agent who supervised plugging of this well Frank Broadfoot  
Producing formation \_\_\_\_\_ Depth to top \_\_\_\_\_ Bottom \_\_\_\_\_ Total Depth of Well 3895 Feet  
Show depth and thickness of all water, oil and gas formations.

OIL, GAS OR WATER RECORDS

CASING RECORD

FORMATION	CONTENT	FROM	TO	SIZE	PUT IN	PULLED OUT
Sand	water	40	85			

Describe in detail the manner in which the well was plugged, indicating where the mud fluid was placed and the method or methods used in introducing it into the hole. If cement or other plugs were used, state the character of same and depth placed, from \_\_\_\_\_ feet to \_\_\_\_\_ feet for each plug set.

Fill hole with heavy mud, plug @246' topped with 1/4 sack hulls and 20 sacks cement through drill pipe. Mud to 35', plug, 1/4 hulls and 10 sacks cement.

(If additional description is necessary, use BACK of this sheet)

Name of Plugging Contractor WILKINSON DRILLING, INC.  
Address 1121 Union National Building, Wichita 2, Kansas

STATE OF Kansas, COUNTY OF Sedgwick, ss.  
Walter M. Wilkinson (employee of owner) or (owner or operator) of the above-described

well, being first duly sworn on oath, says: That I have knowledge of the facts, statements, and matters herein contained and the log of the above-described well as filed and that the same are true and correct. So help me God.

(Signature) Walter M. Wilkinson  
1121 Union National Building, Wichita 2, Kans.  
(Address)

SUBSCRIBED AND SWORN TO before me this 26 day of January, 19 60

My commission expires January 2, 1961

Carolyn K. Moore  
Carolyn K. Moore Notary Public.



WILKINSON DRILLING INCORPORATED

MEMBER UNION NATIONAL BURROUGHS

WICHITA 2, KANSAS  
300 W. COLLEGE

January 28, 1960

15-185-01334-0000

VERNING #1

Company:	Wilkinson Drilling, Inc.	Location:	SW SW NW, Sec. 34-23S-12W
Contractor:	Company Tools		Stafford County, Kansas
Commenced:	January 12, 1960	Elevation:	1867 KB
Completed:	January 20, 1960		1865 DF
Total Depth:	3895'	Casing:	Set 8 5/8" @ 253' w/200 sx.

FIGURES INDICATE BOTTOMS OF FORMATIONS:

FROM	TO	FORMATION
0	- 145	Sand and shale
145	- 1680	Shale and shells
1680	- 3284	Lime and shale
3284	- 3391	Shale and sand
3391	- 3695	Lime and shale
3695	- 3753	Shale and lime
3753	- 3805	Chert
3805	- 3864	Shale and sand stone
3864	- 3895	Arbuckle Dolomite
3895	- Total Depth	

RECEIVED  
STATE COMMISSION

FEB 1 1960

CONSERVATION DIVISION  
Wichita, Kansas

We hereby certify the above and foregoing to be a true and correct copy of the drillers log on the Vering #1, located in the SW SW NW of Section 34-23S-12W, Stafford County, Kansas.

Walter M. Wilkinson

Walter M. Wilkinson

Subscribed and sworn to before me this 28th day of January, 1960.

My commission expires: January 2, 1961

Carolyn K. Moore

RECEIVED  
STATE COMMISSION

FEB 1 1960

CONSERVATION DIVISION  
Wichita, Kansas