


15-185-00991-0000

WELL PLUGGING RECORD

Give All Information Completely  
Make Required Affidavit  
Mail or Deliver Report to:  
Conservation Division  
State Corporation Commission  
806 Bitting Building  
Wichita, Kansas

Stafford County, Sec. 34 Twp. 23S Rge. 12W (E) (W)

Location as "NE/CNW/SW" or footage from lines NE NE NE  
Lease Owner The Texas Company  
Lease Name Mattie Gerdes Well No. 1  
Office Address 614 Bitting Building, Wichita, Kansas  
Character of Well (completed as Oil, Gas or Dry Hole) Dry  
Date well completed May 13 19 55  
Application for plugging filed May 13 19 55  
Application for plugging approved May 13 19 55  
Plugging commenced May 13 19 55  
Plugging completed May 14 19 55  
Reason for abandonment of well or producing formation \_\_\_\_\_

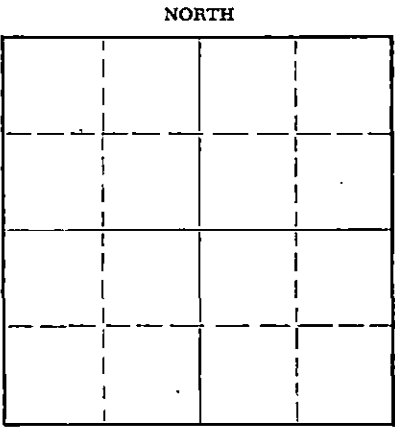

Locate well correctly on above Section Plat

If a producing well is abandoned, date of last production \_\_\_\_\_ 19 \_\_\_\_\_  
Was permission obtained from the Conservation Division or its agents before plugging was commenced? Yes

Name of Conservation Agent who supervised plugging of this well Mr. S. S. Greider  
Producing formation \_\_\_\_\_ Depth to top \_\_\_\_\_ Bottom \_\_\_\_\_ Total Depth of Well 3930 Feet  
Show depth and thickness of all water, oil and gas formations.

OIL, GAS OR WATER RECORDS

CASING RECORD

FORMATION	CONTENT	FROM	TO	SIZE	PUT IN	PULLED OUT
				10-3/4"	678'	0'

Describe in detail the manner in which the well was plugged, indicating where the mud fluid was placed and the method or methods used in introducing it into the hole. If cement or other plugs were used, state the character of same and depth placed, from \_\_\_\_\_ feet to \_\_\_\_\_ feet for each plug set.

PLUGGED AS FOLLOWS:

3930' to 600' - Heavy Mud  
600' - Halliburton Plug  
600' to 562' - 20 Sacks Cement  
562' to 30' - Heavy Mud  
30' - Halliburton Plug  
30' to Bottom of Cellar - 1 Sack Hulls  
and 10 Sacks Cement

(If additional description is necessary, use BACK of this sheet)

Name of Plugging Contractor Stickle Drilling Company  
Address Box 117, Great Bend, Kansas

STATE OF Kansas, COUNTY OF Sedgwick, ss.  
M. C. Harrell (employee of owner) or (owner or operator) of the above-described well, being first duly sworn on oath, says: That I have knowledge of the facts, statements, and matters herein contained and the log of the above-described well as filed and that the same are true and correct. So help me God.

(Signature) M. C. Harrell  
614 Bitting Building, Wichita, Kansas  
(Address)

SUBSCRIBED AND SWORN to before me this 17th day of May, 19 55

My commission expires Sept. 20, 1956

H. Howard Kistler Notary Public.  
CORPORATION COMMISSION

PLUGGING  
FILE SEC 34 T 23 R 12W  
BOOK PAGE 118 LINE 30

JUN 2 1955 6-2-55  
CONSERVATION DIVISION  
Wichita, Kansas

State

# LOG OF WELL

FORM NO. 1 SHEET 1 (4-54) 35M  
15-185-00921-0000  
SHEET 1

## MATTIE GERDES NO. 1

OWNER The Texas Company DIVISION Oklahoma DATE MADE May 25, 1955  
 DISTRICT Kansas LEASE Mattie Gerdes WELL NO. 1  
 STATE Kansas COUNTY OR PARISH Stafford TWP. 23S RANGE 12W SEC. 34  
 LOCATION OF WELL NE NE NE

COMMENCED RIGGING UP 4-27-55 COMMENCED DRILLING 4-27-55 COMPLETED DRILLING 3-14-55  
 DAY DRILLER \_\_\_\_\_ NIGHT DRILLER \_\_\_\_\_ CONTRACTOR Stickle Drilling Co.  
 CABLE FROM \_\_\_\_\_ TO \_\_\_\_\_ ROTARY FROM 0' TO 3930' COMPANY LOG NO. \_\_\_\_\_  
 TOTAL DEPTH 3930' MEASURED BY M. C. Harrell ELEVATION KB - 1863  
DF - 1861  
GL - 1859

### CASING RECORD

SIZE	WEIGHT	PUT IN WELL		PULLED OUT		LOST IN WELL		SHOES		PACKERS			
		FEET	INS.	FEET	INS.	FEET	INS.	LENGTH	MAKE	KIND	LENGTH	SET AT	
10-3/4"	32.75#	678'				(R-2, J-55,		new casing)					FT.
													FT.
													FT.
10-3/4" casing set at 658' with 500 sacks cement, 1/4# flocele per sack and 5 sacks CC. Cement circulated.

WAS CASING CEMENTED? \_\_\_\_\_ IF SO, HOW MANY SACKS OF CEMENT USED? \_\_\_\_\_  
 LINER: STATE SIZE AND WEIGHT \_\_\_\_\_ WHERE SET \_\_\_\_\_ FT. AND INS. BLANK \_\_\_\_\_ FT AND INS. PERFORATED \_\_\_\_\_  
 HOW PUT TOGETHER \_\_\_\_\_ COUPLING \_\_\_\_\_ FLUSH-JOINT \_\_\_\_\_ INSERTED \_\_\_\_\_  
 REMARKS: \_\_\_\_\_

### EQUIPMENT RECORD

TUBING				SUCKER RODS			PUMPING OUTFIT
SIZE	WEIGHT	FEET	INS.	FEET	INS.	SIZE AND KIND	DESCRIPTION, KIND, SIZE, ETC

Completed plugging 3-14-55

FLOWING, PUMPING, GASSEY OR DRY Dry PRODUCTION FIRST 24 HOURS \_\_\_\_\_ PRODUCTION SETTLED \_\_\_\_\_  
 IF GAS WELL, OPEN FLOW CAPACITY \_\_\_\_\_ SHUT IN PRESSURE \_\_\_\_\_ ROCK PRESSURE \_\_\_\_\_  
 KIND OF SHOT \_\_\_\_\_ SIZE OF SHOT, QUARTS \_\_\_\_\_  
 NUMBER OF SHELLS \_\_\_\_\_ SIZE OF SHELLS \_\_\_\_\_ INCHES, DIAMETER \_\_\_\_\_  
 LENGTH OF SHELLS \_\_\_\_\_ FEET \_\_\_\_\_ INCHES \_\_\_\_\_ TOP OF SHOT \_\_\_\_\_  
 BOTTOM OF SHOT \_\_\_\_\_ ANCHOR \_\_\_\_\_ WELL BRIDGED TO \_\_\_\_\_  
 TOTAL DEPTH OF WELL \_\_\_\_\_ NUMBER OF SHOT \_\_\_\_\_ PRODUCTION BEFORE SHOT \_\_\_\_\_ BBLs. PER DAY \_\_\_\_\_  
 PRODUCTION AFTER SHOT \_\_\_\_\_ BBLs. PER DAY. SHOT FURNISHED BY \_\_\_\_\_  
 NAME OF SHOOTER \_\_\_\_\_ SHOT INSPECTED \_\_\_\_\_ BY \_\_\_\_\_ (COMPANY EMPLOYEE)  
 COMMENCED DRILLING DEEPER \_\_\_\_\_ COMPLETED \_\_\_\_\_ DRILLING DEEPER \_\_\_\_\_  
 TOTAL DEPTH \_\_\_\_\_ PRODUCTION FIRST 24 HOURS \_\_\_\_\_ PRODUCTION SETTLED \_\_\_\_\_

REMARKS: Mattie Gerdes #1  
Rank-Wildcat  
TD 3930'  
Completed Drilling 3-14-55  
Completed Plugging 3-14-55

NOTE: IF WELL WAS DRY, STATE UNDER REMARKS, WHEN, HOW, AND BY WHOM PLUGGED. STATE UNDER REMARKS ANYTHING OF INTEREST NOT COVERED IN LOG. CONSERVE IF THE SPACE PROVIDED FOR REMARKS IS NOT SUFFICIENT WRITE ON BOTTOM OF LAST SHEET OF LOG.

**PLUGGING**  
 FILE SEC 34 T 23 R 12W  
 BOOK PAGE 118 LINE 30

TOTAL NUMBER OF SHEETS \_\_\_\_\_

# LOG OF WELL

SHEET No. 2

District Kansas Owner The Texas Company Farm Mattie Gardes Well No. 1

FORMATION	AMOUNT	COLOR	HARD OR SOFT	DEPTH CORES TAKEN	REMARKS
<u>REMARKS:</u>					
5-8-55	Ran DST #1 from 3450-68'				open 1 hour, recovered 15' mud. SIBHP 12# in 30 minutes.
5-9-55	Ran DST #2 from 3481-3506'				gassy slightly oil cut mud. SIBHP 1170# in 30 minutes.
5-11-55	Ran DST #3 from 3746-70'				IFP 22#, FFP 25#, SIBHP 105# in 20 minutes.
5-12-55	Ran DST #4 from 3766-90'				mud. SIBHP 292# in 20 minutes.
5-14-55	Drilled to 3930'. Ran Electric Log. Well non-commercial. Plugged and abandoned.				
<u>TOPS:</u>					
Cimarron Dolomite- 639					
Topeka-----2949					
Heebner-----3235					
Douglas-----3268					
Brown Lansing----3382					
Lansing-----3410					
Conglomerate----3742					
Viola-----3758					
Simpson-----3827					
Arbuckle-----3886					

The Texas Company  
Tulsa, Oklahoma

Tulsa, Oklahoma  
May 16, 1955

CONTRACTOR: Stickle Drilling Company  
Drilling Commenced: April 27, 1955  
Drilling Completed: May 13, 1955

Mattie Gerdes #1 NE-NE  
NE Section 34-23S-12W,  
Stafford County, Kansas.

DRILLERS LOG

15-185-60991-0000

Clay	0-50
Sand	50-400
Red Bed	400-648
Anhydrite	648-670
Shale & Shells	670-1053
Shale & Lime	1053-1585
Lime & Shale	1585-1775
Shale & Lime	1775-2290
Shale	2290-2440
Shale & Lime	2440-2585
Shale	2585-2690
Shale & Lime	2690-2942
Lime & Shale	2942-3130
Chalky Lime	3130-3202
Lime	3202-3244
Shale & Lime	3244-3316
Shale	3316-3384
Lime	3384-3770
Cherty Lime	3770-3823
Shale & Lime	3823-3862
Lime	3862-3930 TD

I, Frank E. Stickle, hereby certify the above to be a true and complete Drillers Log of The Texas Company's Mattie Gerdes #1 NE NE NE Section 34-23S-12W, Stafford County, Kansas.

Frank E. Stickle

Lillian T. Bonham

Notary Public

February 13, 1956

My Commission Expires