


WELL PLUGGING RECORD

Give All Information Completely  
Make Required Affidavit  
Mail or Deliver Report to:  
Conservation Division  
State Corporation Commission  
212 North Market, Insurance Bldg.  
Wichita, Kansas

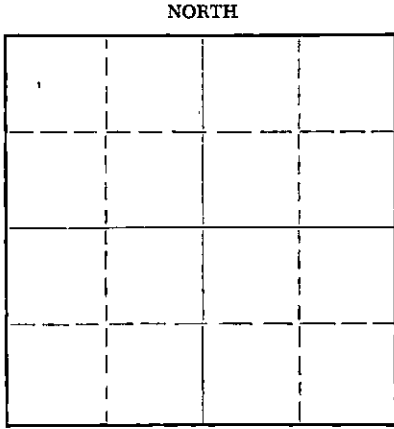

Locate well correctly on above  
Section Plat

Stafford County. Sec. 35 Twp. 23 Rge. 12W (E)      (W)  
Location as "NE/CNW/SW" or footage from lines. Approx. N/2 NW SW  
Lease Owner Hellar Drilling Company, Inc.  
Lease Name Kelly Well No. 1  
Office Address 1014 Union Center, Wichita, Kansas  
Character of Well (completed as Oil, Gas or Dry Hole) Dry Hole  
Date well completed 4-14 19 60  
Application for plugging filed 4-14 19 60  
Application for plugging approved 4-14 19 60  
Plugging commenced 4-14 19 60  
Plugging completed 4-14 19 60  
Reason for abandonment of well or producing formation Dry Hole

If a producing well is abandoned, date of last production      19       
Was permission obtained from the Conservation Division or its agents before plugging was commenced? Yes

Name of Conservation Agent who supervised plugging of this well Frank Broadfoot  
Producing formation      Depth to top      Bottom      Total Depth of Well 3857 Feet  
Show depth and thickness of all water, oil and gas formations.

OIL, GAS OR WATER RECORDS

CASING RECORD

FORMATION	CONTENT	FROM	TO	SIZE	PUT IN	PULLED OUT
		0	197	8-5/8"	200.92'	None

Describe in detail the manner in which the well was plugged, indicating where the mud fluid was placed and the method or methods used in introducing it into the hole. If cement or other plugs were used, state the character of same and depth placed, from      feet to      feet for each plug set.

Set bottom plug at 180' with 1/2 sack hulls and 20 sacks cement. Set top plug at 35' with 1/2 sack hulls and 10 sacks cement.


RECEIVED  
STATE CORPORATION COMMISSION  
APR 22 1960  
CONSERVATION DIVISION  
Wichita, Kansas

(If additional description is necessary, use BACK of this sheet)  
Name of Plugging Contractor Hellar Drilling Company, Inc.  
Address 1014 Union Center, Wichita, Kansas

STATE OF KANSAS, COUNTY OF SEDGWICK, ss.  
D. L. Hellar (employee of owner) or (owner or operator) of the above-described well, being first duly sworn on oath, says: That I have knowledge of the facts, statements, and matters herein contained and the log of the above-described well as filed and that the same are true and correct. So help me God.

(Signature) [Signature]  
1014 Union Center  
(Address)

Subscribed and Sworn to before me this 19th day of April, 19 60  
Wanda Lou Bruce  
Notary Public.

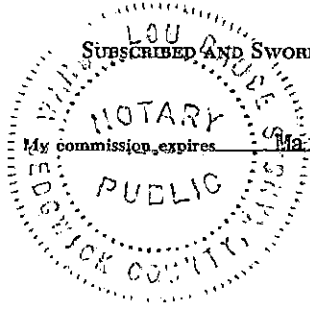

WELL LOG

15-185-19391-0000

OWNER: Hellar Drilling Company, Inc.  
 LEASE: Kelly #1  
 LOCATION: Approx. N/2 NW SW Section 35-23-12W  
 Stafford County, Kansas  
 COMMENCED: April 4, 1960  
 COMPLETED: April 14, 1960  
 CASING: 8-5/8" surface casing set @ 197'  
 w/200 sacks cement

0 - 197 Surface sand, red bed  
 197 - 460 Red bed & shale  
 460 - 632 Shale  
 632 - 672 Anhydrite  
 672 - 1375 Shale  
 1375 - 1765 Shale & lime  
 1765 - 1958 Ft. Riley section  
 1958 - 2855 Lime & shale  
 2855 - 2998 Topeka lime  
 2998 - 3288 Lime & shale  
 3288 - 3376 Douglas shale  
 3376 - 3392 Brown lime  
 3392 - 3455 Kansas City lime  
 3455 - 3570 Lime  
 3570 - 3589 Lansing Kansas City  
 3589 - 3620 Lime  
 3620 - 3682 Base Kansas City lime  
 3682 - 3756 Lime  
 3756 - 3778 Viola Chert  
 3778 - 3826 Viola & Simpson  
 3826 - 3857 Lime  
 3857 Rotary Total Depth  
 D & A

RECEIVED  
 STATE CORPORATION COMMISSION  
 APR 22 1960  
 CONSERVATION DIVISION  
 Wichita, Kansas

STATE OF KANSAS )  
 COUNTY OF SEDGWICK ) SS:

I, D. L. Hellar, do hereby certify that the above and foregoing is a true and correct copy of the log of the KELLY #1, located approximately N/2 NW SW of Section 35-23-12W, Stafford County, Kansas, as reflected by the files of the Hellar Drilling Company, Inc.

HELLAR DRILLING COMPANY, INC.

BY D. L. Hellar  
 D. L. Hellar, President

Subscribed and sworn to before me, a Notary Public, in and for Sedgwick County, Kansas, this 19th day of April, 1960.

Wanda Lou Bruce  
 Notary Public

My commission expires March 6, 1961.

