

15-185-30191-0000

STATE OF KANSAS  
STATE CORPORATION COMMISSION

Form CP-4


Give All Information Completely  
Make Required Affidavit  
Mail or Deliver Report to:  
Conservation Division  
State Corporation Commission  
211 No. Broadway  
Wichita, Kansas

WELL PLUGGING RECORD

STAFFORD County, Sec. 35 Twp. 23 Rge. 12 (X) (W)

Location as "NE/CNW/SW" or footage from lines SE SW SW  
Lease Owner PETROLEUM, INC.,  
Lease Name BROCK "C" Well No. 1  
Office Address R.R. #2, GREAT BEND, KANSAS  
Character of Well (completed as Oil, Gas or Dry Hole) DRY HOLE  
Date well completed Nov. 22 19 65  
Application for plugging filed Nov. 22 19 65  
Application for plugging approved Nov. 22 19 65  
Plugging commenced Nov. 22 19 65  
Plugging completed Nov. 22 19 65  
Reason for abandonment of well or producing formation NO PRODUCIBLE ZONE

NORTH

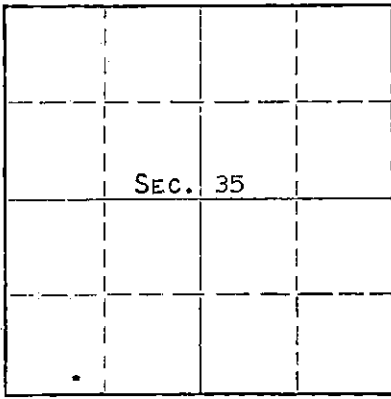

Locate well correctly on above  
Section Plat

If a producing well is abandoned, date of last production NONE 19  
Was permission obtained from the Conservation Division or its agents before plugging was commenced? YES

Name of Conservation Agent who supervised plugging of this well ARCHIE ELVING  
Producing formation \_\_\_\_\_ Depth to top \_\_\_\_\_ Bottom \_\_\_\_\_ Total Depth of Well 3440 Feet  
Show depth and thickness of all water, oil and gas formations.

OIL, GAS OR WATER RECORDS

CASING RECORD

FORMATION	CONTENT	FROM	TO	SIZE	PUT IN	PULLED OUT
				8-5/8"	227'	NONE

Describe in detail the manner in which the well was plugged, indicating where the mud fluid was placed and the method or methods used in introducing it into the hole. If cement or other plugs were used, state the character of same and depth placed, from \_\_\_\_\_ feet to \_\_\_\_\_ feet for each plug set.

MUDDED UP WITH HEAVY MUD TO 200', FOLLOWED BY WOODEN PLUG, PLACED 25 SACKS CEMENT ON TOP OF PLUG. MUDDED UP WITH HEAVY MUD TO 40', FOLLOWED BY WOODEN PLUG, PLACED 1/2 SACK HULLS AND 10 SACKS CEMENT ON TOP OF PLUG TO BASE OF WELL CELLAR.

11-29-65  
RECEIVED  
STATE CORPORATION COMMISSION  
NOV 29 1965  
CONSERVATION DIVISION  
Wichita, Kansas

(If additional description is necessary, use BACK of this sheet)

Name of Plugging Contractor GARVEY DRILLING COMPANY  
Address R.R. #2, GREAT BEND, KANSAS

STATE OF KANSAS, COUNTY OF BARTON, ss.  
MONTE CHADD (employee of owner) or (owner or operator) of the above-described well, being first duly sworn on oath, says: That I have knowledge of the facts, statements, and matters herein contained and the log of the above-described well as filed and that the same are true and correct. So help me God.

(Signature) MONTE CHADD, M.S.P. PROD. SUPT.

(Address)

SUBSCRIBED AND SWORN TO before me this 26 day of NOVEMBER, 19 65

Richard N. Dangler

Notary Public.

My commission expires MAY 28, 1969

# WELL LOG

15-185-3091-0060

COMPANY Petroleum, Inc.

SEC. 35 T. 23S R. 12W

FARM Brock

NO. C-1

LOC. SE SW SW


TOTAL DEPTH 3440'

COUNTY Stafford

COMM. 11-16-65

COMP. 11-21-65

CONTRACTOR Garvey Drilling Company

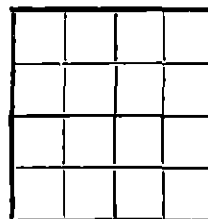

CASING 8 5/8" @ 227' w/230 sx

ELEVATION 1854' DF

PRODUCTION D & A

FIGURES INDICATE BOTTOM OF FORMATIONS

80' Surface Clay and Sand  
 227' Shale  
 960' Shale, Shells and Red Bed  
 1530' Shale and Shells  
 2215' Lime and Shale  
 2590' Shale and Lime  
 2860' Shale with Lime Streaks  
 2970' Shale and Lime  
 3440' Lime and Shale  
 3440' RTD

RECEIVED  
 STATE CORPORATION COMMISSION  
 NOV 29 1965  
 CONSERVATION DIVISION  
 Wichita, Kansas

State of Kansas }  
 County of Barton } SS

I, Sam N. Stephens of Garvey Drilling Company

upon oath state the above and foregoing is a true and correct copy of the log of the Brock No. C-1 well.

Sam N. Stephens

Subscribed and sworn to before me this 23rd day of November 19 65

My Commission Expires: November 5, 1969

Richard Hoops  
 NOTARY PUBLIC