

STATE OF KANSAS
STATE CORPORATION COMMISSION


Form CP-4

Give All Information Completely
Make Required Affidavit
Mail or Deliver Report to:
Conservation Division
State Corporation Commission
P. O. Box 17027
Wichita, Kansas 67217
NORTH

WELL PLUGGING RECORD

Stafford County, Sec. 31 Twp. 22S Rge. 11W (E) (W)
SW NE

Location as "NE/CNW/SW" or footage from lines _____
Lease Owner Clinton Oil Company
Lease Name Heyen B#10 Well No. _____
Office Address Great Bend, Kansas 67530
Character of Well (completed as Oil, Gas or Dry Hole) Oil
Date well completed 11-8-39 19____
Application for plugging filed 8-18 1972
Application for plugging approved 8-21 1972
Plugging commenced 8/23/72 19____
Plugging completed 8/24/72 19____
Reason for abandonment of well or producing formation depleted.

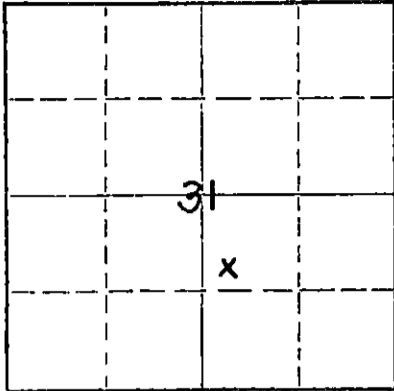

Locate well correctly on above
Section Plat

If a producing well is abandoned, date of last production 8-71 19____
Was permission obtained from the Conservation Division or its agents before plugging was commenced? yes

Name of Conservation Agent who supervised plugging of this well Biberstein
Producing formation Arbuckle Depth to top 3532 Bottom 3542 Total Depth of Well 3542 Feet
Show depth and thickness of all water, oil and gas formations. (open-hole)

OIL, GAS OR WATER RECORDS				CASING RECORD		
FORMATION	CONTENT	FROM	TO	SIZE	PUT IN	PULLED OUT
Arbuckle	Oil	3513	TD	13"	247	none
				6"	3532	278'

Describe in detail the manner in which the well was plugged, indicating where the mud fluid was placed and the method or methods used in introducing it into the hole. If cement or other plugs were used, state the character of same and depth placed, from _____ feet to _____ feet for each plug set.

Checked hole to 347', couldn't knock bridge out. Shot pipe at 279' and pulled 9 joints. Set 10' rock bridge at 200' and plugged with 6 yards concrete.

PLUGGING COMPLETE.

RECEIVED
STATE CORPORATION COMMISSION

SEP 13 1972

CONSERVATION DIVISION
Wichita, Kansas

(If additional description is necessary, use BACK of this sheet)
Name of Plugging Contractor KNIGHT CASING PULLING CO., INC.
Address CHASE, KANSAS

STATE OF KANSAS, COUNTY OF RICE, ss.
NOEL J. KNIGHT (employee of owner) or (owner or operator) of the above-described well, being first duly sworn on oath, says: That I have knowledge of the facts, statements, and matters herein contained and the log of the above-described well as filed and that the same are true and correct. So help me God.

(Signature) *Noel Knight*
CHASE, KANSAS
(Address)

SUBSCRIBED AND SWORN TO before me this 31st day of August, 19 72

My commission expires _____
MARGARET MELCHER
NOTARY PUBLIC
Rice County, Kansas
My Commission Expires
Feb. 15, 1975

Margaret Melcher
Notary Public.

FORMATION RECORD

Give detailed description and thickness of all formations drilled through and contents of sand, whether dry, water, oil or gas.

Formation	Top	Bottom	Formation	Top	Bottom
Cellar	0	5'7"			
Surface clay	6'7"	20			
sand	20	105			
sahel	105	248			
red shale	248	535			
anhydrite	535	564			
red bed and shale	564	818			
red bed	818	874			
shale & shells	874	1012			
shale	1012	1060			
salt and shale	1060	1272			
shale	1272	1400			
shale and shells	1400	1440			
lime	1440	1506			
anhydrite and lime	1506	1555			
broken lime	1555	1565			
shale	1565	1630			
broken shale and lime	1630	1677			
shale and shells	1677	1705			
soft lime	1705	1720			
shale	1720	1828			
lime	1828	1898			
shale and shells	1898	1946			
shale and lime	1946	2036			
broken lime	2036	2098			
lime	2098	2120			
shale	2120	2193			
shale and shells	2193	2312			
shale and shells	2312	2392			
shale	2392	2450			
lime	2450	2465			
shale	2465	2515			
shale and lime	2515	2566			
lime and shale	2566	2584			
shale	2584	2659			
shale and shells	2659	2764			
shale	2764	2770			
lime	2770	2850			
broken lime	2850	2886			
lime	2886	3066			
broken shale, red and black	3066	3121			
shale and lime	3121	3150			
shale	3150	3181			
shale lime and shells	3181	3232			
lime	3232	3513			
Simpson, shale and sand	3513	3536			
Coring Record					
Dolomite-very porous with good oil show	3536	3542			
Top of Siliceosu	3534				
Date of first work	9-19-37				
Date drilling started	9-27-37				
Date drilling completed	10-11-37				
Date well completed	10-27-37				
Date potential eff.	10-28-37				

RECEIVED
STATE CORPORATION COMMISSION
AUG 21 1972
CONSERVATION DIVISION
Wichita, Kansas

32
1811
-1476