


WELL PLUGGING RECORD

Give All Information Completely  
Make Required Affidavit  
Mail or Deliver Report to:  
Conservation Division  
State Corporation Commission  
211 No. Broadway  
Wichita, Kansas

NORTH

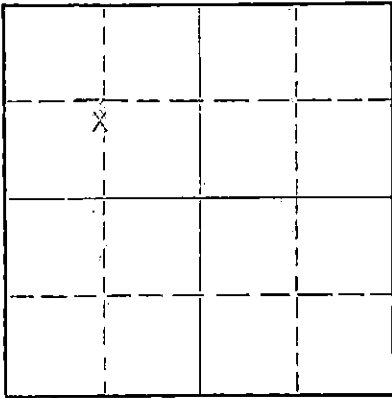

Locate well correctly on above  
Section Plat

Hodgeman County. Sec. 9 Twp. 22S Rge. 22W (E) (W)  
Location as "NE/CNW/SW" or footage from lines 2043' NL, 660' WL, SW NW  
Lease Owner Shell Oil Company  
Lease Name Miller Well No. 1-9  
Office Address 1200 First National Building - Oklahoma City 2, Oklahoma  
Character of Well (completed as Oil, Gas or Dry Hole) Dry Hole  
Date well completed 7-31 19 62  
Application for plugging filed 8-1 19 62  
Application for plugging approved 8-2 19 62  
Plugging commenced 8-2 19 62  
Plugging completed 8-3 19 62  
Reason for abandonment of well or producing formation Dry hole

If a producing well is abandoned, date of last production --- 19 ---  
Was permission obtained from the Conservation Division or its agents before plugging was commenced? Yes

Name of Conservation Agent who supervised plugging of this well Hugh Scott, Box 1223, Liberal, Kansas  
Producing formation --- Depth to top --- Bottom --- Total Depth of Well 4593 Feet  
Show depth and thickness of all water, oil and gas formations.

OIL, GAS OR WATER RECORDS

CASING RECORD

| FORMATION | CONTENT | FROM | TO | SIZE  | PUT IN | PULLED OUT |
|-----------|---------|------|----|-------|--------|------------|
|           |         |      |    | 8-5/8 | 256    | NONE       |
|           |         |      |    |       |        |            |
|           |         |      |    |       |        |            |
Describe in detail the manner in which the well was plugged, indicating where the mud fluid was placed and the method or methods used in introducing it into the hole. If cement or other plugs were used, state the character of same and depth placed, from see remarks feet to feet for each plug set.

Loaded hole with mud, spotted 35 sacks of cement plug at base of surface casing. Capped hole with 15 sacks of cement. Plugged Abandoned Complete.

RECEIVED  
STATE CORPORATION COMMISSION

AUG 10 1962

CONSERVATION DIVISION  
Wichita, Kansas

(If additional description is necessary, use BACK of this sheet)  
Name of Plugging Contractor Shell Oil Company License #275  
Address 1200 First National Building - Oklahoma City 2, Oklahoma

STATE OF Oklahoma, COUNTY OF Oklahoma, ss.  
C. A. Wischoff

(employee of owner) or (owner or operator) of the above-described well, being first duly sworn on oath, says: That I have knowledge of the facts, statements, and matters herein contained and the log of the above-described well as filed and that the same are true and correct. So help me God.

(Signature) C. A. Wischoff  
1200 First National Building - Okla. City, Okla.  
(Address)

SUBSCRIBED AND SWORN TO before me this 9th day of August, 1962

My commission expires June 11, 1966

Notary Public.



Shell-Miller 1-9  
 SW NW Section 9-22S-22W  
 Hanston Field  
 Hodgeman County, Kansas

FORMATION RECORD

| <u>TOP</u> | <u>BOTTOM</u> | <u>FORMATION</u>                     |
|------------|---------------|--------------------------------------|
| 0          | 220           | Surface Sand & Shale                 |
| 220        | 1200          | Shale                                |
| 1200       | 3000          | Interbedded Shale & Lime & Anhydrite |
| 3000       | 4420          | Interbedded Lime & Shale             |
| 4420       | 4450          | Shale                                |
| 4450       | 4471          | Lime & Chert (Mississippi Chert Top) |
| 4471       | 4593          | Interbedded Chert & Lime             |
|            | TD 4593       |                                      |

**RECEIVED**  
 STATE CORPORATION COMMISSION

AUG - 1962

CONSERVATION DIVISION  
 Wichita, Kansas

SHELL OIL COMPANY - Operator

SIERRA PETROLEUM CO., INC. - Contractor

E. MILLER #1-9  
C SW NW  
Sec. 9-22S-22W  
Hodgeman County, Kansas

T. D.: 4593'

Commenced: 7-16-62  
Completed: 7-28-62

RECEIVED  
STATE CORPORATION COMMISSION  
AUG 2 1962  
CONSERVATION DIVISION  
Topeka, Kansas

Casing:  
8-5/8" Set at 267'

Cement:  
with 200 sx. Pozmix

| FORMATION               | DEPTH |
|-------------------------|-------|
| Clay & Sand             | 40    |
| Sand & Post Rock        | 125   |
| Sand & Shale            | 270   |
| Shale                   | 535   |
| Red Bed & Shale         | 788   |
| Sand                    | 1120  |
| Shale                   | 1410  |
| Lime & Shale            | 1450  |
| Red Bed, Shale & Shells | 1710  |
| Shale & Shells          | 1930  |
| Shale & Salt            | 2165  |
| Shale & Shells          | 2170  |
| Lime & Shale            | 2440  |
| Lime                    | 2575  |
| Lime & Shale            | 2923  |
| Shale & Shells          | 3125  |
| Shale & Lime            | 3295  |
| Lime & Shale Streaks    | 3410  |
| Shale & Lime            | 3955  |
| Lime                    | 4545  |
| Lime & Chert            | 4570  |
| Lime                    | 4593  |

STATE OF KANSAS )  
                          ) ss:  
COUNTY OF RUSSELL )

I hereby certify that the above information is true and correct to the best of my knowledge.

C. T. Honaker  
Drilling Superintendent

Subscribed and sworn to before me this 2nd day of August, 1962.

Erroy Dietz  
Notary Public

My Commission Expires: 10-17-63