


STATE OF KANSAS
STATE CORPORATION COMMISSION

Give All Information Completely
Make Required Affidavit
Mail or Deliver Report to:
Conservation Division
State Corporation Commission
212 No. Market
Wichita, Kansas

WELL PLUGGING RECORD

Pawnee County. Sec. 12 Twp. 22S Rge. 15W (E) (W)
Location as "NE/CNW/SW" or footage from lines NE SW NE
Lease Owner Alpine Oil & Royalty Co., Inc.
Lease Name McMillan Well No. 1
Office Address 800 Bitting Building, Wichita, Kansas 67202
Character of Well (completed as Oil, Gas or Dry Hole) Dry hole
Date well completed April 2 1968
Application for plugging filed April 2, 1968 (by phone) 19
Application for plugging approved April 2, 1968 (by phone) 19
Plugging commenced April 2, 1968 19
Plugging completed April 2, 1968 19
Reason for abandonment of well or producing formation Nonproductive in commercial quantities
If a producing well is abandoned, date of last production _____ 19____
Was permission obtained from the Conservation Division or its agents before plugging was commenced? Yes

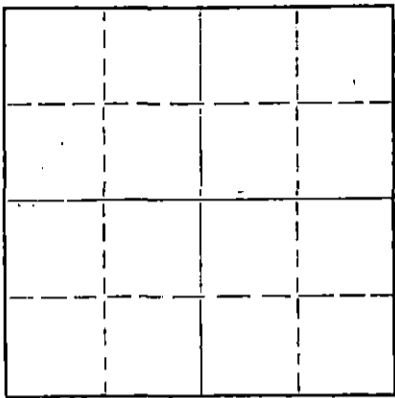

Locate well correctly on above Section Plat

Name of Conservation Agent who supervised plugging of this well Leo Massey
Producing formation _____ Depth to top _____ Bottom _____ Total Depth of Well 3955 Feet
Show depth and thickness of all water, oil and gas formations.

OIL, GAS OR WATER RECORDS

CASING RECORD

FORMATION	CONTENT	FROM	TO	SIZE	PUT IN	PULLED OUT
				8 5/8"	316 ft	Cemented

Describe in detail the manner in which the well was plugged, indicating where the mud fluid was placed and the method or methods used in introducing it into the hole. If cement or other plugs were used, state the character of same and depth placed, from _____ feet to _____ feet for each plug set.

Heavy mud from total depth to 540 feet. Plug and 70 sacks cement at 540 feet. Plug to 300 feet and 26 sacks cement. Plug and bridge to hold Kelly at 40 feet; 10 sacks cement to bottom of cellar. 2 sacks cement for rat hole.

RECEIVED
STATE CORPORATION COMMISSION
APR 5 1968
CONSERVATION DIVISION
Wichita, Kansas

(If additional description is necessary, use BACK of this sheet)

Name of Plugging Contractor Gabbert-Jones, Inc.
Address 830 Sutton Place, Wichita, Kansas 67202

STATE OF Kansas, COUNTY OF Sedgwick, ss.
Dwight J. Wilson (employee of owner) or (owner or operator) of the above-described well, being first duly sworn on oath, says: That I have knowledge of the facts, statements, and matters herein contained and the log of the above-described well as filed and that the same are true and correct. So help me God.

(Signature) Dwight J. Wilson
Bitting Bldg., Wichita, Kansas 67202 (Address)

Subscribed and sworn to before me this 5th day of April, 1968

Evelyn Wanko
Evelyn Wanko Notary Public.

December 10, 1968



GABBERT-JONES, INC.
WICHITA, KANSAS
DRILLERS' WELL LOG

MC MILLAN #1
 NE SW NE SECTION 12-22S-15W
 PAWNEE COUNTY, KANSAS

COMMENCED: MARCH 26, 1968
 COMPLETED: APRIL 2, 1968

OPERATOR - ALPINE OIL & ROYALTY Co., INC.

DEPTH		FORMATION	REMARKS
FROM	TO		
0	255	SURFACE CLAY AND SAND	RAN 8 JOINTS OF 8-5/8" CASING, SET @ 316' w/275 SACKS CEMENT.
255	316	SHALE AND RED BED	
316	895	SHALE AND RED. BED	
895	935	ANHYDRITE	
935	1600	SHALE AND SALT	
1600	2024	SHALE AND LIME	
2024	2230	LIME	
2230	3110	LIME AND SHALE	
3110	3219	CHALK, LIME AND SHALE	
3219	3515	LIME AND SHALE	
3515	3655	LIME	
3655	3745	LIME AND SHALE	
3745	3830	SHALE AND CHERT	
3830	3838	CHERT	
3838	3875	SAND AND SHALE	
3875	3897	LIME AND SHALE	
3897	3955	ARBUCKLE	
3955	TD		DRY AND ABANDONED.

RECEIVED
 STATE CORPORATION COMMISSION
 APR 5 1968
 CONSERVATION DIVISION
 Wichita, Kansas

I, E. E. HALL, CERTIFY THIS IS A CORRECT COPY OF THE DRILLERS' LOG FOR THE WELL DRILLED IN THE NE SW NE SECTION 12-22S-15W, PAWNEE COUNTY, KANSAS, TO THE BEST OF MY KNOWLEDGE AND BELIEF.

E. E. Hall

 E. E. HALL

STATE OF KANSAS)
) SS
 COUNTY OF SEDGWICK)

BEFORE ME, THE UNDERSIGNED, A NOTARY PUBLIC WITHIN AND FOR SAID COUNTY AND STATE, ON THIS 4TH DAY OF APRIL, 1968, PERSONALLY APPEARED E. E. HALL, TO ME PERSONALLY KNOWN TO BE THE IDENTICAL PERSON WHO EXECUTED THE WITHIN AND FOREGOING INSTRUMENT AND ACKNOWLEDGED TO ME THAT HE EXECUTED THE SAME AS HIS FREE AND VOLUNTARY ACT AND DEED FOR THE USES AND PURPOSES THEREIN SET FORTH.

IN WITNESS WHEREOF, I HAVE HEREUNTO SET MY HAND AND OFFICIAL SEAL THE DAY AND YEAR LAST ABOVE WRITTEN.

Barbara J. Layton

 BARBARA J. LAYTON, NOTARY PUBLIC

My COMMISSION EXPIRES FEBRUARY 1, 1972.

