


Give All Information Completely
Make Required Affidavit
Mail or Deliver Report to:
Conservation Division
State Corporation Commission
212 North Market, Insurance Bldg.
Wichita, Kansas

WELL PLUGGING RECORD

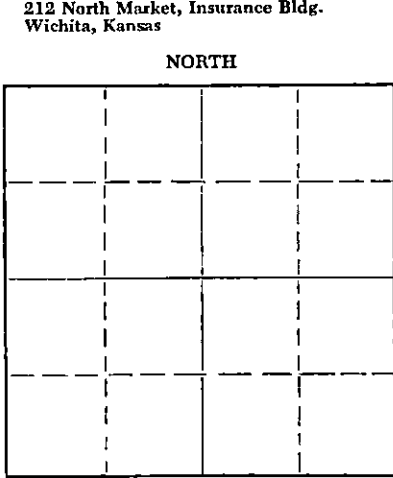

Locate well correctly on above
Section Plat

Pawnee County, Sec. 20 Twp. 22S Rge. (E) 15(W)
Location as "NE/CNW/SW" or footage from lines NE SE SE
Lease Owner Chief, Sunray Mid-Continent & R. W. Shields
Lease Name Stromer Well No. 1
Office Address P. O. Box 97 - Great Bend, Kansas
Character of Well (completed as Oil, Gas or Dry Hole) Dry Hole
Date well completed March 3 19 59
Application for plugging filed March 5 19 59
Application for plugging approved _____ 19 _____
Plugging commenced March 5 19 59
Plugging completed 7:30 P.M. March 5 19 59
Reason for abandonment of well or producing formation _____

If a producing well is abandoned, date of last production _____ 19 _____
Was permission obtained from the Conservation Division or its agents before plugging was commenced? Yes

Name of Conservation Agent who supervised plugging of this well Frank Broadfoot
Producing formation _____ Depth to top _____ Bottom _____ Total Depth of Well 4035 Feet
Show depth and thickness of all water, oil and gas formations.

OIL, GAS OR WATER RECORDS

CASING RECORD

FORMATION	CONTENT	FROM	TO	SIZE	PUT IN	PULLED OUT
				8-5/8"	261'	-0-

Describe in detail the manner in which the well was plugged, indicating where the mud fluid was placed and the method or methods used in introducing it into the hole. If cement or other plugs were used, state the character of same and depth placed, from _____ feet to _____ feet for each plug set.

First plug set at 240' with 1/3 sack hulls, 20 sacks cement.

Second plug set at 35' with 1/3 sack hulls, 10 sacks cement.

RECEIVED
STATE CORPORATION COMMISSION

MAR 7 1959

CONSERV
Wich...

(If additional description is necessary, use BACK of this sheet)

Name of Plugging Contractor _____
Address _____

STATE OF KANSAS, COUNTY OF BARTON, ss.
V. Richard Hoover (employee of owner) or (owner or operator) of the above-described well, being first duly sworn on oath, says: That I have knowledge of the facts, statements, and matters herein contained and the log of the above-described well as filed and that the same are true and correct. So help me God.

(Signature) V. Richard Hoover
Chief Drilling Co., Inc., Box 97, Great Bend, Kans.
(Address)

SUBSCRIBED AND SWORN TO before me this 5th day of March, 19 59

Mary O. Johnson
Notary Public.

My commission expires November 21, 1959

PLUGGING
FILE SEC. 20 T. 22 R. 15W
BOOK PAGE 24 LINE 13

WELL LOG

Operator : Chief Drilling Co., Inc., Sunray Mid-Continent Oil Company and R. W. Shields
 Farm : STROMER
 Well No. : 1
 Location : NE SE SE, Sec. 20-22S-15W
 Pawnee County, Kansas
 Elevation: 2002 G.L.
 2004 D.F.
 2007 K.B.

Commenced: February 20, 1959
 Completed: March 3, 1959
 Contractor: Chief Drilling Co., Inc.
 Rotary : 0 - 4035' Total Depth

DRY AND ABANDONED

CASING RECORD: 8-5/8" surface casing set and cemented at 261' with 200 sacks Pozmix cement. Cement circulated.

Figures Indicate Bottoms of Formations:

Sand and Shale	0 -	261	
Shale	261	385	
Red Bed & Shale	385	430	
Sand	430	510	
Shale and Shells	510	966	
Anhydrite	966	996	
Shale	996	1431	
Shale and Shells	1431	1800	
Lime and Shale	1800	1810	
Lime and Shale	1810	3300	
Lime	3300	4035	Total Depth

STATE OF KANSAS)
) SS:
 COUNTY OF BARTON)

I hereby certify that the above is a true and correct copy of Drillers' Log of well drilled in the NE SE SE of Section 20, Township 22 South, Range 15 West, Pawnee County, Kansas, to the best of my knowledge and belief.

CHIEF DRILLING CO., INC.

V. Richard Hoover
 V. Richard Hoover, President

Subscribed and sworn to before me this 5th day of March, 1959

RECEIVED
 STATE CORPORATION COMMISSION
 MAR 7 1959
 CONSERVATION DIVISION
 Kansas

Mary O. Johnson
 Mary O. Johnson, Notary Public

My Commission Expires:
 November 21, 1959

PLUGGING
 FILE SEC. 20 T. 22 R. 15W
 BOOK PAGE 24 LINE 13