


STATE OF KANSAS  
STATE CORPORATION COMMISSION

Form CP-4

Give All Information Completely  
Make Required Affidavit  
Mail or Deliver Report to:  
Conservation Division  
State Corporation Commission

WELL PLUGGING RECORD

P. O. Box 17027  
Wichita, Kansas 67217  
NORTH

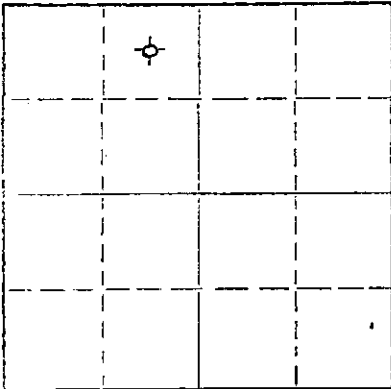

Locate well correctly on above  
Section Flat

Hodgeman County. Sec. 10 Twp. 22S Rge. 21 (X) (W)  
Location as "NE/CNW/SW" or footage from lines C NE NW  
Lease Owner Mack Oil Co.  
Lease Name Norris Well No. 1  
Office Address 812 Union Center Bldg, Wichita, KS 67202  
Character of Well (completed as Oil, Gas or Dry Hole) dry hole  
Date well completed 2-20-75 19  
Application for plugging filed 2-20-75 19  
Application for plugging approved 2-20-75 19  
Plugging commenced 2-20-75 19  
Plugging completed 2-20-75 19  
Reason for abandonment of well or producing formation commercial quantities  
of oil not found.  
If a producing well is abandoned, date of last production 19  
Was permission obtained from the Conservation Division or its agents before plugging was com-  
menced? yes

Name of Conservation Agent who supervised plugging of this well Clarence Thomas-Garden City, KS  
Producing formation \_\_\_\_\_ Depth to top \_\_\_\_\_ Bottom \_\_\_\_\_ Total Depth of Well 4400 Feet  
Show depth and thickness of all water; oil and gas formations.

OIL, GAS OR WATER RECORDS

CASING RECORD

FORMATION	CONTENT	FROM	TO	SIZE	PUT IN	PULLED OUT
				8-5/8"	370'	

Describe in detail the manner in which the well was plugged, indicating where the mud fluid was placed and the method or methods used in introducing it into the hole. If cement or other plugs were used, state the character of same and depth placed, from \_\_\_\_\_ feet to \_\_\_\_\_ feet for each plug set.

RECEIVED  
STATE CORPORATION COMMISSION

1st plug @ 900' w/50 sx  
2nd plug @ 500' w/35 sx  
3rd plug @ 40' w/15 sx

MAR 3 1975 3-3-75

CONSERVATION DIVISION  
Wichita, Kansas

(If additional description is necessary, use BACK of this sheet)  
Name of Plugging Contractor Rains & Williamson Oil Co., Inc.  
Address 435 Page Court, 220 W. Douglas, Wichita, KS 67202

STATE OF Kansas COUNTY OF Sedgwick, ss.  
Wilson Rains, President (employee of owner) or (owner or operator) of the above-described well, being first duly sworn on oath, says: That I have knowledge of the facts, statements, and matters herein contained and the log of the above-described well as filed and that the same are true and correct. So help me God.

(Signature) Wilson Rains Wilson Rains  
435 Page Court, 220 W. Douglas, Wichita, KS 67202  
(Address)

Subscribed and Sworn to before me this 21st day of February, 1975  
My commission expires October 4, 1975.

Juanita M. Green  
Juanita M. Green Notary Public.



# WELL LOG

COMPANY Mack Oil Co.

SEC. 10 T. 22S R. 21 W  
LOC. C NE NW

FARM Norris

NO. 1


RIG. NO. 8

TOTAL DEPTH 4400'

COMM. 2-2-75

COMP. 2-20-75

COUNTY Hodgeman  
KANSAS

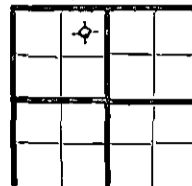

CONTRACTOR Rains & Williamson Oil Co., Inc.

CASING  
20 10  
15  
12 6  
13 5

8-5/8" @ 370' w/250 sx common, 2% gel ELEVATION  
3% cc

PRODUCTION D&A

FIGURES INDICATE BOTTOM OF FORMATIONS

Surface	433
Shale & Redbed	6684
Shale	725
Dakota	867
Shale	1280
Anhydrite	1307
Shale	2117
Shale & Lime	2272
Lime & Shale	3840
Lime	3860
Lime & Shale	4100
Lime	4400
<u>Rotary Total Depth</u>	<u>4400</u>

RECEIVED  
STATE CORPORATION COMMISSION  
MAR 3 1975  
CONSERVATION DIVISION  
Wichita, Kansas

State of Kansas  
County of Sedgwick } ss:

I, Wilson Rains, President of the Rains & Williamson Oil Company Inc.

upon oath state that the above and foregoing is a true and correct copy of the log of the Norris #1 well.

Wilson Rains Wilson Rains

Subscribed and sworn to before me this 21st day of February 19 75

My Commission Expires: October 4, 1975

Juanita M. Green  
NOTARY PUBLIC  
Juanita M. Green

