

STATE OF KANSAS
STATE CORPORATION COMMISSION

WELL PLUGGING RECORD

Give All Information Completely
Make Required Affidavit
Mail or Deliver Report to:
Conservation Division
State Corporation Commission
211 No. Broadway
Wichita, Kansas

Stafford County, Sec. 7 Twp. 22 Rge. 12W (E) (W)

Location as "NE/CNW/SW" or footage from lines: W/2 SE NE

Lease Owner Sinclair Oil & Gas Company

Lease Name Cora B. Crawford Well No. 3

Office Address P. O. Box 521, Tulsa, Oklahoma

Character of Well (completed as Oil, Gas or Dry Hole) Depleted Oil Well

Date well completed June 21, 19 44

Application for plugging filed July 2, 19 57

Application for plugging approved July 3, 19 57


Plugging commenced July 27, 19 57

Plugging completed July 31, 19 57

Reason for abandonment of well or producing formation Depleted oil well. No other possible producing formation.

If a producing well is abandoned, date of last production July 19 53

Was permission obtained from the Conservation Division or its agents before plugging was commenced? Yes

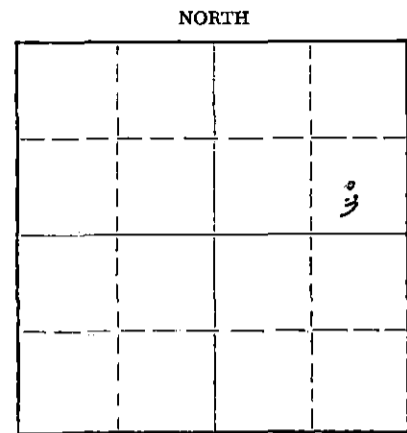

Locate well correctly on above Section Plat

Name of Conservation Agent who supervised plugging of this well Milton Galyardt

Producing formation Arbuckle Depth to top 3660 1/2 Bottom 3662 1/2 Total Depth of Well 3662 1/2 Feet

Show depth and thickness of all water, oil and gas formations.

OIL, GAS OR WATER RECORDS

CASING RECORD

FORMATION	CONTENT	FROM	TO	SIZE	PUT IN	PULLED OUT
Arbuckle	Oil Depleted	3660 1/2	3662 1/2	9"	280	None
				5 1/2"	3660 1/2	1827'

Describe in detail the manner in which the well was plugged, indicating where the mud fluid was placed and the method or methods used in introducing it into the hole. If cement or other plugs were used, state the character of same and depth placed, from _____ feet to _____ feet for each plug set.

Checked hole to 3662 1/2' and found it open.

Filled hole from 3662 1/2' to 3650' with sand. Filled hole 3650' to 3615' with 5 sacks of cement. Shot off 5 1/2" casing at 2933, 2818, 2725, 2598, 2507, 2403, 2307, 1982, 1827', worked casing loose and pulled 30 joints. Circulated casing with 30 sacks of gel mud. Pulled 27 joints of casing, bailed hole to 250'. Set 10' rock bridge from 250' to 240'. Filled hole from 240' to 180' with 20 sacks of cement. Filled hole from 180' to 25' with mud. Set 10' rock bridge 25' to 15', filled hole from 15' to base of cellar with 5 sacks of cement.

(If additional description is necessary, use BACK of this sheet)

Name of Plugging Contractor West Supply Co., Inc.

Address Chase, Kansas

STATE OF Kansas COUNTY OF Rice, ss.

W. B. Rhees (employee of owner) or Conservation Division of the above-described

well, being first duly sworn on oath, says: That I have knowledge of the facts, statements, and matters herein contained and the log of the above-described well as filed and that the same are true and correct. So help me God.

(Signature) W. B. Rhees

P. O. Box 551, Chase, Kansas (Address)

SUBSCRIBED AND SWORN TO before me this 7 day of August, 19 57

My commission expires 21 October 1959

William C. Head Notary Public.

PLUGGING
FILE SEC 7 T. 22 R. 12W
BOOK PAGE 25 LINE 11

AUG 8 1957

CONSERVATION DIVISION
Wichita, Kansas

Well Log
Sinclair Oil & Gas Company

Cora Crawford #3
660' fm Sth, 560' fm West lines
Se/4, NE/4, 7-22-12W Stafford Co., Kans.
Elev. 1873'

Harbar Drilling Co., rotary
Began drlg. May 23, 1944
Comp. drlg. June 7, 1944
T.D. 3662 $\frac{1}{2}$ ' in Arb.
6/21/1944 pumped 144 bbl oil in 12 hrs
giving Min. 25 bbl potential.
6/29/1944 took Draw-down test for
pot. 1959 bbls oil, 10% wtr. after
2000 acid.

Drillers Log

Sandy Clay	40'
Surface Sand	165
Red Bed	310
Red Bed & Shells	480
Red Bed & Shells	975
Shale & Shells	1050
Salt	1250
Shale & Shells	1780
Lime & Shale	1830
Lime-sandy	1885
Lime-cherty	1920
Lime-hard	1950
Shale-lime	2340
Lime-Shale	2715
Shale-Lime	2745
Lime & Shale	2860
Shale-Lime	2900
Shale & Shells	2930
Shale & Lime	2985
Lime	3045
Shale & Lime	3115
Lime & Shale	3235
Shale & Lime	3280
Lime & Shale	3395
Lime	3565
Chert	3575
Cherty Lime	3600
Chert	3610
Shale	3662 $\frac{1}{2}$ ' TD

9" OD set @280' derr. flr.	277'	Surface Lev.	200sx	
5-1/2" OD set @	3660'	"	3657'	125sx
Top Arbuckle	3660'	"	3657'	"
Total Depth	3662 $\frac{1}{2}$ '	"	3659 $\frac{1}{2}$ '	

CIE V/E
GARDNER
587
BENSER DIVISION
Wichita, Kansas

PLUGGING
FIL" SEC 7 T. 22 R. 12W
BOOK PAGE 35 LINE 11