


STATE OF KANSAS  
STATE CORPORATION COMMISSION

WELL PLUGGING RECORD  
OR  
FORMATION PLUGGING RECORD

Strike out upper line  
when reporting plug-  
ging off formations.

Give All Information Completely  
Make Required Affidavit  
Mail or Deliver Report to:  
Conservation Division  
State Corporation Commission  
800 Biting Building  
Wichita, Kansas

NORTH

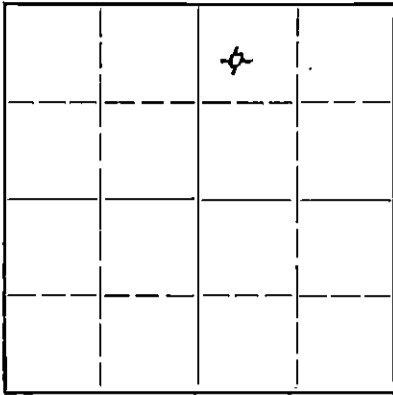

Locate well correctly on above  
Section Plat

Stafford County, Sec. 24 Twp. 22 Rge. 12W(E) (W)  
Location as "NE1/4NW1/4SW1/4" or footage from lines 760' from north line 2080'  
Lease Owner Champlin Refining Co. from east line of NE1/4  
Lease Name Hahn Well No. 1  
Office Address Box 552, Enid, Oklahoma  
Character of Well (completed as Oil, Gas or Dry Hole) Dry Hole  
Date well completed May 1, 1944 19  
Application for plugging filed May 1, 1944 19  
Application for plugging approved May 1, 1944 19  
Plugging commenced May 1, 1944 19  
Plugging completed May 1, 1944 19  
Reason for abandonment of well or producing formation

If a producing well is abandoned, date of last production 19  
Was permission obtained from the Conservation Division or its agents before plugging was com-  
menced? Yes

Name of Conservation Agent who supervised plugging of this well Mr. Petty  
Producing formation Depth to top Bottom Total Depth of Well 3676' Feet  
Show depth and thickness of all water, oil and gas formations.

OIL, GAS OR WATER RECORDS


CASING RECORD

Formation	Content	From	To	Size	Put In	Pulled Out
				10-3/4"	220'	None

Describe in detail the manner in which the well was plugged, indicating where the mud fluid was placed and the method or methods used in introducing it into the hold. If cement or other plugs were used, state the character of same and depth placed, from feet to feet for each plug set.

Filled hole with heavy rotary mud from 3676' to 220', bottom of surface casing and used 10 sacks of cement to bridge from 220' to 200' and then filled with heavy rotary mud from 200' to 15' and used 5 sacks of cement to bridge from 15' to 5' - bottom of cellar

All casing used was left in hole as listed below:  
220' of 10-3/4" O.D. Spiral Weld Surface Casing.

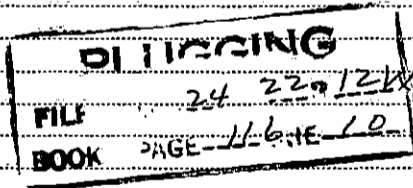

(If additional description is necessary, use BACK of this sheet)

Correspondence regarding this well should be addressed to Champlin Refining Company  
Address Box 552  
Enid, Oklahoma

STATE OF Oklahoma, COUNTY OF Garfield, ss.  
F. C. Wentworth (employee of Champlin Refining Company) of the above-described well,  
being first duly sworn on oath, says: That I have knowledge of the facts, statements, and matters herein contained and the log of the above-described well as filed and that the same are true and correct. So help me God.

(Signature) F. C. Wentworth

Box 552 - Enid, Oklahoma (Address)

SUBSCRIBED AND SWORN TO before me this 5th day of May 1944 5-11-44  
Jane M. Bell Notary Public

My commission expires May 25, 1946.



FORMATION

0	161	Surface clay and sand
161	190	Red Bed & Clay
190	220	Red Bed & Lime Shells
220	395	Red Shale & Shells
395	585	Red Bed
585	810	Anhydrite & Lime
810	1050	Red Bed & Shale
1050	1275	Shale, Shells & Salt
1275	1510	Shale & Lime Shells
1510	1835	Lime
1835	1888	Sand & Lime
1888	1910	Lime & Shale
1910	1985	Lime
1985	2052	Sand & Lime
2052	2161	Shale & Lime
2161	2200	Lime
2200	2390	Lime & Shale
2390	2415	Lime
2415	2435	Shale
2435	2500	Lime & Shale
2500	2620	Lime & Shale
2620	2648	Blue Shale
2648	2680	Lime
2680	2800	Shale & Shells
2800	2860	Lime & Shale
2860	3153	Lime
3153	3175	Lime & Shale
3175	3278	Shale
3278	3491	Lime
3491	3566	Lime & Shale
3566	3580	Conglomerate & Chert
3580	3593	Lime
3593	3595	Lime & Chert
3595	3609	Green Shale & Chert
3609	3623	Lime & Shale
3623	3653	Shale & Lime
3653	3676	Lime
3676		Total Depth