


Give All Information Completely  
Make Required Affidavit  
Mail or Deliver Report to:  
Conservation Division  
State Corporation Commission  
211 No. Broadway  
Wichita, Kansas

WELL PLUGGING RECORD

Stafford County. Sec. 24 Twp. 22S Rge. (E)12 (W)  
Location as "NE/CNW/SW" or footage from lines SE SE SW  
Lease Owner Jetmar Production Company  
Lease Name Mershon Well No. 1  
Office Address Box 736, Great Bend, Kansas  
Character of Well (completed as Oil, Gas or Dry Hole) oil  
Date well completed \_\_\_\_\_ 19\_\_\_\_  
Application for plugging filed October 14 1965  
Application for plugging approved \_\_\_\_\_ 19\_\_\_\_  
Plugging commenced October 26 1965  
Plugging completed November 1 1965  
Reason for abandonment of well or producing formation depleted

NORTH

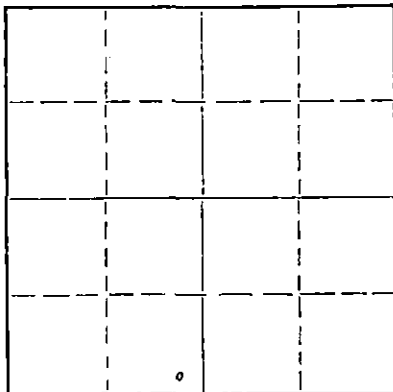

Locate well correctly on above  
Section Plat

If a producing well is abandoned, date of last production \_\_\_\_\_ 19\_\_\_\_  
Was permission obtained from the Conservation Division or its agents before plugging was commenced? yes

Name of Conservation Agent who supervised plugging of this well Archie Elving  
Producing formation \_\_\_\_\_ Depth to top \_\_\_\_\_ Bottom \_\_\_\_\_ Total Depth of Well 3656 Feet  
Show depth and thickness of all water, oil and gas formations.

OIL, GAS OR WATER RECORDS

CASING RECORD

FORMATION	CONTENT	FROM	TO	SIZE	PUT IN	PULLED OUT
				8 5/8"	256'	none
				4 1/2"	3652 1/2'	2837.06

Describe in detail the manner in which the well was plugged, indicating where the mud fluid was placed and the method or methods used in introducing it into the hole. If cement or other plugs were used, state the character of same and depth placed, from \_\_\_\_\_ feet to \_\_\_\_\_ feet for each plug set.

Pushed plug to 3300'. Dumped 30' of sand on plug. Mixed and dumped 3 sacks of cement on sand.

Pushed plug to 240', set 10' rock bridge and dumped 6 sacks of cement. Let set. Bail hole down. Dumped 19 sacks of cement. Filled hole with mud to 40', set 10' rock bridge and dumped 10 sacks of cement.

RECEIVED  
STATE CORPORATION COMMISSION

NOV 18 1965

CONSERVATION DIVISION  
Wichita, Kansas

(If additional description is necessary, use BACK of this sheet)  
Name of Plugging Contractor Pipe Pullers, Inc.  
Address Box 486, Ellinwood, Kansas

STATE OF Kansas, COUNTY OF Barton, ss.  
Dean Wells (employee of owner) or (owner or operator) of the above-described well, being first duly sworn on oath, says: That I have knowledge of the facts, statements, and matters herein contained and the log of the above-described well as filed and that the same are true and correct. So help me God.

(Signature) Dean Wells

Ellinwood, Kansas  
(Address)

SUBSCRIBED AND SWORN to before me this 15th day of November, 1965

My commission expires Feb. 10, 1967

George A. Meyer  
(Notary Public)

CONTRACTOR'S WELL LOG

COMPANY: Wilkinson Drilling, Inc.  
 CONTRACTOR: Abercrombie Drilling, Inc.  
 WERSON #1  
 LOCATION: SE SE SW  
 Sec. 24-22S-12W  
 Stafford County, Kansas  
 COMMENCED: March 14, 1964  
 COMPLETED: March 25, 1964

0	170	Sand
170	266	Red Bed
256	1255	Shale & Shells
1255	2044	Shale & Lime
2044	2225	Shale W/ Lime Streaks
2225	2927	Shale & Lime
2927	3580	Lime
3580	3652	Lime & Chert
3652	3656	Arbuckle
3656		Rotary Total Depth

Set 8-5/8" surface casing at 256' w/200 ex cement.

Set 4-1/2" at 3652-1/2' w/125 ex cement.

ELEVATION: 1848' G. L.  
 1854' K. B.

**ELECTRIC LOG TOPS:**

Heebner	3126'	(-1272)
Toronto	3145'	(-1291)
Douglas	3160'	(-1306)
Brown Lim e	3262'	(-1408)
Lansing	3287'	(-1433)
Base Kansas City	3515'	(-1661)
Conglomerate	3547'	(-1693)
Viola	3554'	(-1700)
Simpson	3604'	(-1750)
Arbuckle	3654'	(-1800)
Log T. D.	3656'	(-1802)

RECEIVED  
 STATE CORPORATION COMMISSION

OCT 15 1965

CONSERVATION DIVISION  
 Wichita, Kansas

STATE OF KANSAS )  
 ) SS  
 COUNTY OF SEDGWICK )

I, B. Lynn Harrington, do hereby certify that the above and foregoing is a true and correct copy of the log of the WERSON #1, SE SE SW, Section 24-22S-12W Stafford County, Kansas, as reflected by the files of Abercrombie Drilling, Inc.

B. Lynn Harrington  
 B. Lynn Harrington,

Subscribed and sworn to before me, a Notary Public, in and for Sedgwick County, Kansas, this 1st day of April, 1964.

Leah Faye Hafko  
 Leah Faye Hafko, Notary Public

My commission expires June 16, 1967