

STATE OF KANSAS  
STATE CORPORATION COMMISSION


WELL PLUGGING RECORD

OR  
FORMATION PLUGGING RECORD

Strike out upper line  
when reporting plug-  
ging of formations.

Give All Information Completely  
Make Required Affidavit  
Mail or Deliver Report to:  
Conservation Division  
State Corporation Commission  
800 Bittling Building  
Wichita, Kansas

Stafford County, Sec. 24 Twp. 22 Rge. 12W (E) (W)  
Location as "NE1/4NW1/4SW1/4" or footage from lines 330' SL 330' WL  
Lease Owner Lotus Oil Co - H. A. Hershfield & Co.  
Lease Name Heyen Well No. 1-B  
Office Address Hoke Bldg. Hutchinson, Ks.  
Character of Well (completed as Oil, Gas or Dry Hole) Dry Hole  
Date well completed 7/14 1944  
Application for plugging filed 8/28 1944  
Application for plugging approved 8/29 1944  
Plugging commenced 8/29 1944  
Plugging completed 8/30 1944  
Reason for abandonment of well or producing formation Dry Hole  
If a producing well is abandoned, date of last production 19  
Was permission obtained from the Conservation Division or its agents before plugging was com-  
menced? Yes

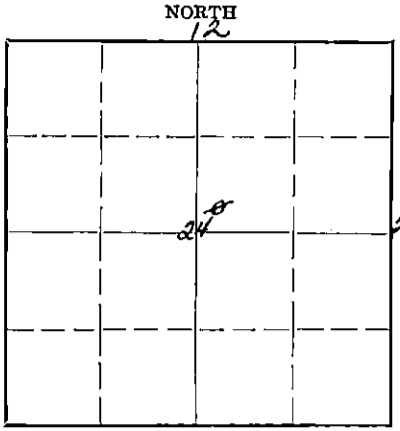

Locate well correctly on above  
Section Plat

Name of Conservation Agent who supervised plugging of this well Dale Dirke  
Producing formation Arbuckle Depth to top 3653 1/2 Bottom 3674 Total Depth of Well 3674 Feet  
Show depth and thickness of all water, oil and gas formations.

OIL, GAS OR WATER RECORDS

CASING RECORD

Formation	Content	From	To	Size	Put In	Pulled Out
				10-3/4"	210	None
				5-1/2"	3649	3378' - 8"

Describe in detail the manner in which the well was plugged, indicating where the mud fluid was placed and the method or methods used in introducing it into the hole. If cement or other plugs were used, state the character of same and depth placed, from feet to feet for each plug set.

Cemented from 3674 - 3620  
Filled with heavy mud to 220 - 20 Skcs Cement  
5 Skcs Cement on top.

9-18-44

PLUGGING  
FILE 24 22-212W  
BOOK 6129 NE 24

SEP 1 1944

(If additional description is necessary, use BACK of this sheet)  
Correspondence regarding this well should be addressed to H. A. Hershfield & Co.  
Address Hoke Bldg., Hutchinson, Ks.

STATE OF KANSAS, COUNTY OF RENO, ss.  
(employee of owner) or (owner or operator) of the above-described well,

being first duly sworn on oath, says: That I have knowledge of the facts, statements, and matters herein contained and the log of the above-described well as filed and that the same are true and correct. So help me God.

(Signature) H. A. Hershfield  
Hoke Bldg., Hutchinson, Ks.  
(Address)

SUBSCRIBED AND SWORN to before me this 16th day of September, 1944, 19

My commission expires Mar 10, 1948  
Notary Public.

LOG OF WELL #1-3  
Sec. 24-22-12, Stafford County

DRILED FOR: H. A. HUTCHINGS & CO. - LOGAN OIL CO.  
DRILED BY: WILSON FIELD DRILLING COMPANY

COMMENCED: 6/21/44  
COMPLETED: 7/14/44


Sand	to	30
Sand & Shale	"	155
Red Shale	"	510
Sand & Shells	"	595
Shale & Shells	"	1095
Salt	"	1300
Shale & Shells	"	1425
Shale & Sandy Lime	"	1528
Broken Lime	"	1850
Sandy Lime	"	1958
Shale & Shells	"	1992
Lime	"	2057
Broken Lime	"	2275
Lime	"	2321
Broken Lime	"	2386
Lime	"	2412
Shale & Shells	"	2450
Lime	"	2458
Shale	"	2504
Lime	"	2545
Shale	"	2565
Lime	"	2692
Shale & Shells	"	2850
Lime	"	2869
Shale & Shells	"	2905
Topsoil Lime	"	3224
Shale & Shells	"	3268
Lime	"	3478
Shale & Shells	"	3553
Lime	"	3584
Shale & Conglomerate	"	3620
Green Shale	"	3619
Sand	"	3633
Artificial Polomite	"	3655 T.D.

Casing Record

210' - 10-3/4" - Cemented 200 Sko.  
3619' - 5-1/2" - Cemented 90 Sko.

Cable Tool 3655 - 3659 - Slight show  
of Oil. Hole full of Water. D.M.

All measurements based on Rotary Table  
on Derrick Floor.

 

LOGGING  
FILE: 24 22-12-12  
BOOK: 6129 LINE-24