

STATE OF KANSAS
STATE CORPORATION COMMISSION

Form CP-4


Give All Information Completely
Make Required Affidavit
Mail or Deliver Report to:
Conservation Division
State Corporation Commission
211 No. Broadway
Wichita, Kansas

WELL PLUGGING RECORD

Stafford County. Sec. 24 Twp. 22S Rge. (E) 12 (W)

Location as "NE/CNW&SW" or footage from lines SW SE SW
Lease Owner Jetmar Production Company
Lease Name Mershon Well No. 2
Office Address Box 736, Great Bend, Kansas
Character of Well (completed as Oil, Gas or Dry Hole) SWD
Date well completed 19
Application for plugging filed October 14 1965
Application for plugging approved 19
Plugging commenced November 2 1965
Plugging completed November 6 1965
Reason for abandonment of well or producing formation no longer needed

NORTH

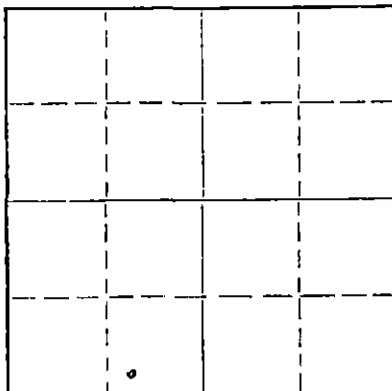

Locate well correctly on above
Section Plat

If a producing well is abandoned, date of last production 19
Was permission obtained from the Conservation Division or its agents before plugging was commenced? yes

Name of Conservation Agent who supervised plugging of this well Archie Elving
Producing formation Depth to top Bottom Total Depth of Well 3770 Feet
Show depth and thickness of all water, oil and gas formations.

OIL, GAS OR WATER RECORDS

CASING RECORD

FORMATION	CONTENT	FROM	TO	SIZE	PUT IN	PULLED OUT
				8 3/8"	255'	none
				5 1/2"	3716'	2742.92

Describe in detail the manner in which the well was plugged, indicating where the mud fluid was placed and the method or methods used in introducing it into the hole. If cement or other plugs were used, state the character of same and depth placed, from feet to feet for each plug set.

Pushed plug to 3400'. Dumped 60' of sand on plug. Mixed and dumped 5 sacks of cement on sand.

Pushed plug to 240'. Mixed and dumped 5 sacks of cement on rock bridge. Bailed hole down. Dumped 20 sacks of cement on bridge. Filled hole with mud to 40', set 10' rock bridge and capped hole with 10 sacks of cement.

RECEIVED
STATE CORPORATION COMMISSION
NOV 18 1965
WICHITA, KANSAS

(If additional description is necessary, use BACK of this sheet)

Name of Plugging Contractor Pipe Pullers, Inc.
Address Box 486, Ellinwood, Kansas

STATE OF Kansas, COUNTY OF Barton, ss.
Dean Wells (employee of owner) or (owner or operator) of the above-described well, being first duly sworn on oath, says: That I have knowledge of the facts, statements, and matters herein contained and the log of the above-described well as filed and that the same are true and correct. So help me God.

(Signature) Dean Wells
Ellinwood, Kansas (Address)

SUBSCRIBED AND SWORN TO before me this 15th day of November, 1965

My commission expires Feb. 10, 1967

George A. Meyer
Notary Public

CONTRACTOR'S WELL LOG

COMPANY: Wilkinson Drilling, Inc.
 CONTRACTOR: Abercrombie Drilling, Inc.
 FARM: MERSHON #2
 LOCATION: SW SE SW Sec. 24-22-12W
 Stafford County, Kansas
 COMMENCED: June 4, 1964
 COMPLETED: June 18, 1964

0	180	Sand
180	207	Clay
207	283	Red Bed
283	960	Shale & Sand str.
960	1515	Shale & Shells
1515	1650	Shale & Lime
1650	1800	Lime
1800	3029	Shale & Lime
3029	3097	Lime
3097	3302	Shale & Lime
3302	3553	Lime
3553	3608	Lime & Chert
3608	3665	Lime
3665	3774	Arbuckle
	3774	Rotary Total Depth

Set 8-5/8" surface casing at 255' w/200 sx common cement

Set 5-1/2" longstring at 3716' w/125 sx cement & 23 sx salt.

ELEVATION: 1850' G. L.
 1856' K. B.

ELECTRIC LOG TOPS:

Heebner	3125'	(-1268)
Toronto	3144'	(-1257)
Douglas	3159'	(-1302)
Brown Lime	3259'	(-1402)
Lansing	3284'	(-1427)
Base Kansas City	3516'	(-1659)
Viola	3547'	(-1690)
Simpson	3605'	(-1748)
Arbuckle	3653'	(-1801)
Log T. D.	3770'	

RECEIVED
 STATE CORPORATION COMMISSION
 OCT 15 1965
 CONSERVATION DIVISION
 Wichita, Kansas

STATE OF KANSAS)
) SS
 COUNTY OF SEDGWICK)

I, B. Lynn Herrington, do hereby certify that the above and foregoing is a true and correct copy of the log of the MERSHON #2, SW SE SW Section 24-22-12W, Stafford County, Kansas, as reflected by the files of Abercrombie Drilling, Inc.

B. Lynn Herrington
 B. Lynn Herrington

Subscribed and sworn to before me, a Notary Public, in and for Sedgwick County, Kansas, this 22nd day of June, 1964.

Leah Faye Hejke
 Leah Faye Hejke, Notary Public

My commission expires June 16, 1967.