

STATE OF KANSAS
STATE CORPORATION COMMISSION

Give All Information Completely
Make Required Affidavit
Mail or Deliver Report to
Conservation Division
State Corporation Commission
800 Bitting Building
Wichita, Kansas

WELL PLUGGING RECORD

Stafford County, Sec. 24 Twp. 22 Rge. 12 (E) W (W)

Location as "NE/CNW/SW" or footage from lines NE NE NE

Lease Owner B. E. Ash, et al

Lease Name Hahn Well No. 1

Office Address Box 247, Ellinwood, Kansas

Character of Well (completed as Oil, Gas or Dry Hole) Dry hole

Date well completed 7/14/60 19

Application for plugging filed 7 PM, 7/13/60 19

Application for plugging approved 7 PM, 7/13/60 19


Plugging commenced 3 AM, 7/14/60 19

Plugging completed 9:30 AM, 7/14/1960 19

Reason for abandonment of well or producing formation No commercial production.

If a producing well is abandoned, date of last production 19

Was permission obtained from the Conservation Division or its agents before plugging was commenced? Yes

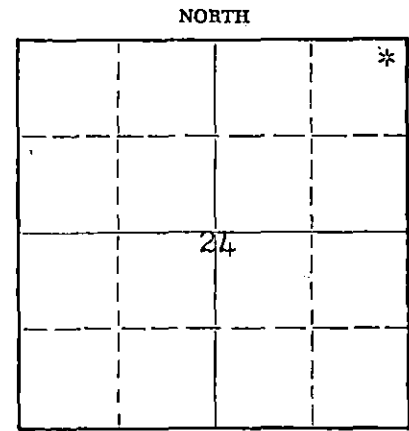

Locate well correctly on above Section Plat

Name of Conservation Agent who supervised plugging of this well Frank Broadfoot, St. John, Kansas

Producing formation ~~XXXXXXX~~ none Depth to top ~~X~~ Bottom Total Depth of Well 3711 Feet

Show depth and thickness of all water, oil and gas formations.

OIL, GAS OR WATER RECORDS

CASING RECORD

FORMATION	CONTENT	FROM	TO	SIZE	PUT IN	PULLED OUT
		0	252	8 5/8"	252	none

Describe in detail the manner in which the well was plugged, indicating where the mud fluid was placed and the method or methods used in introducing it into the hole. If cement or other plugs were used, state the character of same and depth placed, from feet to feet for each plug set.

Filled hole with heavy mud to 240'
Pushed Halliburton plug to 240' w/ drill pipe
Put in one-third sack hulls
Run 20 sacks cement with drill pipe.
Mudded to 35'
Pushed Halliburton plug to 35'
Put in one-third sack hulls
10 sacks of cement filled to bottom of cellar.

RECEIVED
STATE CORPORATION COMMISSION

JUL 18 1960

CONSERVATION DIVISION
Wichita, Kansas

(If additional description is necessary, use BACK of this sheet)

Name of Plugging Contractor Bea Drilling Company, Inc.

Address Box 247, Ellinwood, Kansas

STATE OF Kansas COUNTY OF Barton ss.

B. E. Ash (employee of owner) or (owner or operator) of the above-described well, being first duly sworn on oath, says: That I have knowledge of the facts, statements, and matters herein contained and the log of the above-described well as filed and that the same are true and correct. So help me God.

(Signature) B. E. Ash

Box 247, Ellinwood, Kansas

(Address)

SUBSCRIBED AND SWORN TO before me this 14th day of July 1960

My commission expires November 15, 1962

Thelma S. Ash

Notary Public.



W E L L L O G

Hahn # 1
 NE NE NE
 Sect. 24-22-12W
 Stafford County
 Kansas

Date Staked: 6/25/60
 Date Started: 7/1/60
 Set Surface: 7/2/60
 Date Completed: 7/14/60

Elevation: 1848' Kelly Bushings

Casing Record:

252.37' of 8 5/8" used surface casing. Cemented w/ 150 sax cement, 2 cal. clor., 1 Aquagel.

Formation Tops:		
Heebner	3128	-1280
Brown Lime	3262	-1414
Lansing-KC	3285	-1437
Viola	3570	-1722
Simpson	3606	-1758
Arbuckle	3664	-1816
Rotary TD	3707	-1859

Drill Stem Tests: #1 3660-3669 open 1 hr., recovered 10' mud, slightly oil cut. 20 min. IBHP 40#, FBHP 26#, IFP 12#, FFP 12#

#2 3670-3683 open 1 hr., recovered 30' gcm no show oil, 20 min. IBHP 860#, 20 min. FBHP 205#, IFP 12#, FFP 25#

Log

(Measurements to bottom of formation.)

Sand & clay	50
shale & shells	170
Red shale	220
Shale & shells	252
Shale & shells	590
Anhydrite	615
Shale & shells	1300
Salt & shale	1360
Shale	1540
Lime & shale	1695
Sandy lime & shale	1895
Shale & lime	2745
Lime & shale	3010
Lime	3035
Lime & shale	3110
Lime	3140
Lime & shale	3225
Shale	3264
Lime	3550
Lime & shale	3570
Cherty lime	3608
Shale	3609
Lime & shale	3651
Lime	3711
Rotary Total Depth	3711

RECEIVED
 STATE CORPORATION COMMISSION

JUL 18 1960

CONSERVATION DIVISION
 Wichita, Kansas

I hereby certify that the above is a true and correct log of said well as reflected by the daily drilling reports.

B. E. Ash
 B. E. Ash

STATE OF KANSAS)
)
 COUNTY OF BARTON)

SS.

Subscribed and sworn to before me this 14th day of July, 1960.

Helma L. Ash
 Notary Public

My commission expires November 15, 1962.