


STATE OF KANSAS
STATE CORPORATION COMMISSION

WELL PLUGGING RECORD

Give All Information Completely
Make Required Affidavit
Mail, or Deliver Report to:
Conservation Division
State Corporation Commission
800 Bittling Building
Wichita, Kansas

NORTH

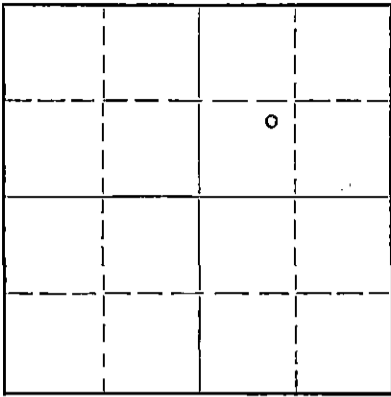

Locate well correctly on above
Section Plat

Stafford County, Sec. 10 Twp. 21 Rge. (E) 13 (W)
Location as "NE/CNW $\frac{1}{4}$ /SW $\frac{1}{4}$ " or footage from lines NE SW NE
Lease Owner Westgate-Greenland Oil Company
Lease Name Ewalt Well No. 3
Office Address 1009 Central Building, Wichita 2, Kansas
Character of Well (completed as Oil, Gas or Dry Hole) oil
Date well completed February 12, 1950 19
Application for plugging filed November 16, 1951 19
Application for plugging approved November 17, 1951 19
Plugging commenced December 19, 1951 19
Plugging completed December 29, 1951 19
Reason for abandonment of well or producing formation oil depleted

If a producing well is abandoned, date of last production November 30, 1951
Was permission obtained from the Conservation Division or its agents before plugging was commenced? YES

Name of Conservation Agent who supervised plugging of this well C. D. Stough
Producing formation Depth to top Bottom Total Depth of Well Feet
Show depth and thickness of all water, oil and gas formations.

OIL, GAS OR WATER RECORDS

CASING RECORD

Formation	Content	From	To	Size	Put In	Pulled Out
surface		0	254	8 5/8"	254	none
Arbuckle	oil	0	3553	5 1/2"	3553	1938 feet

Describe in detail the manner in which the well was plugged, indicating where the mud fluid was placed and the method or methods used in introducing it into the hole. If cement or other plugs were used, state the character of same and depth placed, from feet to feet for each plug set.
Filled hole with crushed rock from TD to 3200 feet.
Ran 5 sacks cement from 3200 to 3165 feet.
Filled with heavy mud from 3165 feet to 260 feet.
Bridged with rock from 260 to 250 feet.
Ran 15 sacks cement from 250 to 205 feet.
Filled with heavy mud from 205 to 30 feet.
Capped with 10 sacks cement from 30 feet to cellar.

(If additional description is necessary, use BACK of this sheet)


Name of Plugging Contractor Morgan Well Plugging Service
Address Hutchinson, Kansas

STATE OF Kansas, COUNTY OF Sedgwick, ss.
G. E. Bitler (employee of owner) or (owner or operator) of the above-described well,
being first duly sworn on oath, says: That I have knowledge of the facts, statements, and matters herein contained and the log of the above-described well as filed and that the same are true and correct. So help me God.

(Signature) G. E. Bitler
1009 Central Building, Wichita 2, Kansas
(Address)

SUBSCRIBED AND SWORN to before me this 12th day of January, 1952
Esther Russell
Notary Public.

My commission expires May 25, 1953

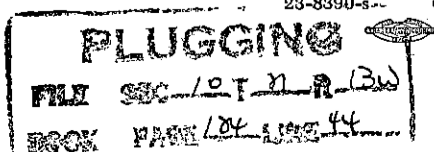

JAN 14 1952
CONSERVATION DIVISION
Wichita, Kansas
1-14-52

COMPANY Westgate-Greenland Oil Company
Mallard Drilling Company

CONTRACTOR: Mallard Drilling Company

FARM: Ewalt #3

LOCATION: NE SW NE Sec. 10-21-13W,
Stafford County, Kansas

commenced January 30, 1950-Rotary
co February 10, 1950-Cardwell

COMPLETED: February 8, 1950-Rotary
February 12, 1950-Cardwell

0	to	85	Sand
85	to	160	Iron and sand
160	to	200	Sand
200	to	254	Shells and shells
254	to	390	Shale
390	to	1130	Shale and shells
1130	to	1585	Shale and lime
1585	to	1865	Lime
1865	to	2165	Lime and shale
2165	to	2750	Shale and lime
2750	to	3150	Lime
3150	to	3300	Shale and lime
3300	to	3553	Lime-T. D. Rotary
3553	to	3557	Lime and shale
3557	to	3560	Arbuckle
		3560	T. D. Cardwell-show of oil

Set 254 feet of 8 5/8" surface. Cemented with 165 sacks cement.


Set 5 1/2" pipe at 3553. Cemented with 75 sacks cement

Acidized with 1000 GA with water @ 3553. Re-acidized
with 2000 GA with water @ 3560.


Minimum well

C E R T I F I C A T E

I, G. E. Bitler, do hereby certify that the above and foregoing is a true and correct log of the Ewalt No. 3, Section 10-21-13W, Stafford County, Kansas, as reflected by files of the Westgate-Greenland Oil Company.

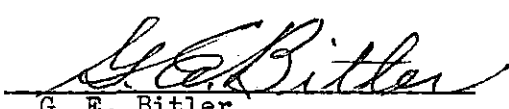
G. E. Bitler

Subscribed and-sworn to before me, a Notary Public, within and for Sedgwick County, Kansas, this 16th day of November, 1951.

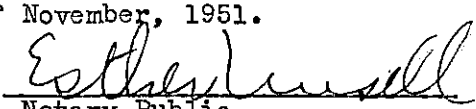
Notary Public

My commission expires May 25, 1953.

ST.

NOV 17 1951

CONFIDENTIAL
Wichita, Kansas

