

WELL PLUGGING RECORD

STATE OF KANSAS STATE CORPORATION COMMISSION

Give All Information Completely Make, Register Affidavit Mail or Deliver Report to: Conservation Division State Corporation Commission 800 Biting Building Wichita, Kansas

FORMATION PLUGGING RECORD

Strike out upper line when reporting plugging off formations.

Stafford County. Sec. 10 Twp. 21 Rge. 13 W. (E) (W)

Location as "NE1/4NW1/4SW1/4" or footage from lines. SE NW SW

Lease Owner The Atlantic Refining Co.

Lease Name Hiss B Well No. 3

Office Address Box 17, Great Bend, Kansas

Character of Well (completed as Oil, Gas or Dry Hole) Dry Hole

Date well completed 3-22 1949

Application for plugging filed 3-22 1949

Application for plugging approved 3-22 1949


Plugging commenced 3-23 1949

Plugging completed 3-23 1949

Reason for abandonment of well or producing formation Dry

If a producing well is abandoned, date of last production 19

Was permission obtained from the Conservation Division or its agents before plugging was commenced? Yes

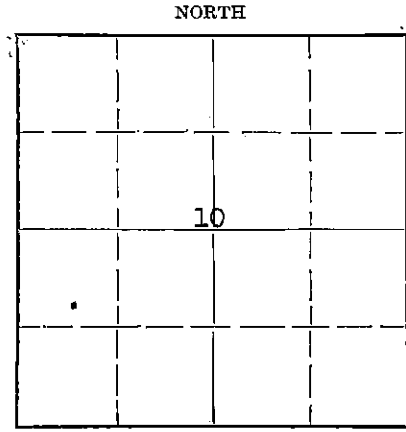

Locate well correctly on above Section Flat

Name of Conservation Agent who supervised plugging of this well Mr. C. D. Stough

Producing formation Depth to top Bottom Total Depth of Well 3660 Feet

Show depth and thickness of all water, oil and gas formations.

OIL, GAS OR WATER RECORDS

CASING RECORD

Table with 7 columns: Formation, Content, From, To, Size, Put In, Pulled Out. Row 1: 8 5/8, 265', 0.

Describe in detail the manner in which the well was plugged, indicating where the mud fluid was placed and the method or methods used in introducing it into the hole. If cement or other plugs were used, state the character of same and depth placed, from feet to feet for each plug set.

Heavy mud 3660' to 240' Bridge at 240' with 15 sacks cement Heavy mud 220' to 20' Ten sacks cement 20' to 6' below ground level

Handwritten notes and stamps: MAR 30 1949, 3-30-49, ST. CORPORATION COMMISSION

Correspondence regarding this well should be addressed to The Atlantic Refining Company Address Box 17, Great Bend, Kansas

STATE OF Kansas COUNTY OF Barton Stanton K. Myers (employee of owner) or (owner or operator) of the above-described well,


being first duly sworn on oath, says: That I have knowledge of the facts, statements, and matters herein contained and the log of the above-described well as filed and that the same are true and correct. So help me God.

(Signature) Stanton K. Myers P. O. Box 17, Great Bend, Kansas (Address)

SUBSCRIBED AND SWORN to before me this 29th day of March, 1949

My commission expires 7-29-51

Notary Public. J. L. Bird

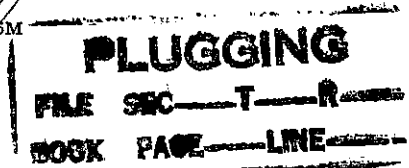

Rothgarn Pool

WELL RECORD

THE ATLANTIC REFINING COMPANY
 330 Kennedy Building
 Tulsa 3, Oklahoma

Block or Twp. 21S - 13W

Lease Hiss "B"
 Lease No. KS-6558
 County Stafford

Well No. 3
 State Kansas

Location Center SE NW SW of
 10-21S-13W
 Elevation 1888 Feet

Drilled (Contract
 Company Tools)

Contracted Depth
 Completed Depth 3660

Feet Date (Started 3-5-49
 Completed 3-23-49
 Deepened
 Cleaned Out)

Name of Contractor Campbell Drilling Company

REACHED T.D.: 3-23-49

Contract Price Per Foot

Day Work

Well Estimated Cost
 Well Actual Cost

Method of Drilling Rotary

BEFORE SHOOTING

AFTER SHOOTING

Initial Production
 Settled Production

Flowing
 on Pump

Initial Production
 Settled Production

Flowing
 on Pump

Baume Test
 DRY HOLE

Water With Oil

%

Casing Record

Torpedo Record

| SIZE | SET | PULLED |
|--------|------|---|
| 8-5/8" | 265' | w/200' sax cement and 200# calcium chloride, set at 273 ft. |

| Date | Company | From | To | Feet | Size of Shell | Total Qts. |
|------|---------|------|----|------|---------------|------------|
|------|---------|------|----|------|---------------|------------|

| FORMATION | TOP | BOTTOM |
|-----------------------|------|--------|
| Clay and sand | 0 | 40 |
| Sandy clay and gravel | 40 | 95 |
| Iron and sand | 95 | 110 |
| Iron | 110 | 120 |
| Pyrite & iron | 120 | 160 |
| Shaley gumbo | 160 | 200 |
| Shale, black | 200 | 258 |
| Lime shells & shale | 258 | 274 |
| Clay & red bed | 274 | 575 |
| Red bed | 575 | 675 |
| Anhydrite | 675 | 705 |
| Shale & lime shells | 705 | 975 |
| Shale & shells | 975 | 1260 |
| Salt & shells | 1260 | 1500 |
| Shale & lime | 1500 | 1575 |
| Lime | 1575 | 1790 |
| Lime & shale | 1790 | 2020 |
| Shale | 2020 | 2080 |
| Shale & lime | 2080 | 2220 |
| Shale | 2220 | 2290 |
| Shale & shells | 2290 | 2375 |
| Shale & lime | 2375 | 2820 |
| Lime & shale | 2820 | 3035 |
| Lime | 3035 | 3260 |
| Shale, sticky | 3260 | 3310 |
| Lime & shale | 3310 | 3345 |
| Lime | 3345 | 3405 |
| Shale & lime | 3405 | 3430 |
| Lime | 3430 | 3548 |
| Lime, chert & shale | 3548 | 3562 |
| Chert & lime | 3562 | 3605 |
| Shale, chert & lime | 3605 | 3660 |

Plugged 3-23-49.
 Plug set at 240' w/15' sax cement.
 Heavy mud and 10' sax cement on top.

10-21-13W
 88-11-16