


STATE OF KANSAS
 STATE CORPORATION COMMISSION
 CONSERVATION DIVISION
 P. O. BOX 17027
 WICHITA, KANSAS 67217

FORM CP-4

WELL PLUGGING RECORD

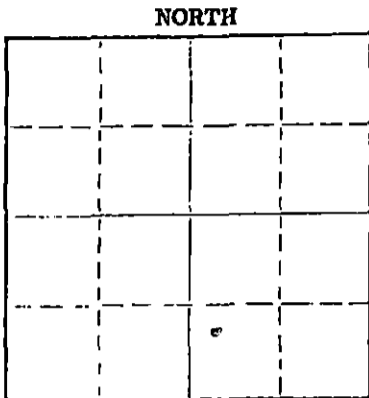

Locate well correctly on above Section Plat

Stafford County. Sec. 10 Twp. 21S Rge. (E) 13 (W)
 Location as "NE/CNW/SW" or footage from lines NW SW SE
 Lease Owner George A. Reed
 Lease Name Rothgarn Well No. 2
 Office Address 645 Fourth Financial Center, Wichita, Kansas
 Character of Well (completed as Oil, Gas or Dry Hole) oil 67202
 Date well completed Aug. 31 1965
 Application for plugging filed Mar. 15 1976
 Application for plugging approved _____ 19____
 Plugging commenced Mar. 16 1976
 Plugging completed Mar. 25 1976
 Reason for abandonment of well or producing formation depleted

If a producing well is abandoned, date of last production _____ 19____
 Was permission obtained from the Conservation Division or its agents before plugging was commenced? yes

Name of Conservation Agent who supervised plugging of this well G. R. Biberstein
 Producing formation _____ Depth to top _____ Bottom _____ Total Depth of Well 3605 Feet
 Show depth and thickness of all water, oil and gas formations.

OIL, GAS OR WATER RECORDS				CASING RECORD		
FORMATION	CONTENT	FROM	TO	SIZE	PUT IN	PULLED OUT
			331'	8 5/8"	331'	none
			3604'	5 1/2"	3604'	2768.50

Describe in detail the manner in which the well was plugged, indicating where the mud fluid was placed and the method or methods used in introducing it into the hole. If cement or other plugs were used, state the character of same and depth placed, from _____ feet to _____ feet for each plug set.

Sanded back to 3500' and dumped 5 sacks of cement.
Halliburton Service plugged well pumping in 2 sacks of hulls, 20 sacks of gel and 100 sacks of cement.
 APR 05 1976
 4-5-76

(If additional description is necessary, use BACK of this sheet)
 Name of Plugging Contractor PIPE PULLERS, INC.
 Address Box 128, Ellinwood, Kansas 67526

STATE OF KANSAS COUNTY OF BARTON, ss.
Evelyn Roth (employee of owner) or (owner or operator) of the above-described well, being first duly sworn on oath, says: That I have knowledge of the facts, statements, and matters herein contained and the log of the above-described well as filed and that the same are true and correct. So help me God.

(Signature) Evelyn Roth
Ellinwood, Kansas
 (Address)

SUBSCRIBED AND SWORN TO before me this 30th day of March, 1976

JENNY KASSELMAN
 NOTARY PUBLIC
 BARTON COUNTY, KANSAS
 MY COMM. EXP. JULY 15, 1973


Jenny Kasselmann
 Notary Public.

STATE OF KANSAS
 STATE CORPORATION COMMISSION
 CONSERVATION DIVISION
 P. O. BOX 17027
 WICHITA, KANSAS 67217

FORM CP-4

WELL PLUGGING RECORD

Stafford County, Sec. 10 Twp. 21S Rge. (E) 13 (W)

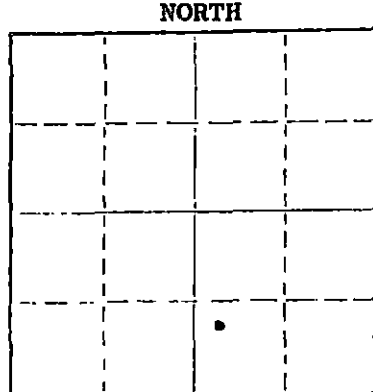

Locate well correctly on above Section Plat

Location as "NE/CNW/SW" or footage from lines NW SW SE
 Lease Owner George A. Reed
 Lease Name Rothgarn Well No. 2
 Office Address 645 Fourth Financial Center, Wichita, Kansas
 Character of Well (completed as Oil, Gas or Dry Hole) oil 67202
 Date well completed Aug. 31 1965
 Application for plugging filed Mar. 15 1976
 Application for plugging approved 19
 Plugging commenced Mar. 16 1976
 Plugging completed Mar. 25 1976
 Reason for abandonment of well or producing formation depleted

If a producing well is abandoned, date of last production 19
 Was permission obtained from the Conservation Division or its agents before plugging was commenced? yes

Name of Conservation Agent who supervised plugging of this well G. R. Biberstein
 Producing formation _____ Depth to top _____ Bottom _____ Total Depth of Well 3605 Feet
 Show depth and thickness of all water, oil and gas formations.

OIL, GAS OR WATER RECORDS				CASING RECORD		
FORMATION	CONTENT	FROM	TO	SIZE	PUT IN	PULLED OUT
			331'	8 5/8"	331'	none
			3604'	5 1/2"	3604'	2768.50

Describe in detail the manner in which the well was plugged, indicating where the mud fluid was placed and the method or methods used in introducing it into the hole. If cement or other plugs were used, state the character of same and depth placed, from _____ feet to _____ feet for each plug set.

Sanded back to 3500' and dumped 5 sacks of cement.
Halliburton Service plugged well pumping in 2 sacks of hulls, 20 sacks of gel and 100 sacks of cement.

Name of Plugging Contractor PIPE PULLERS, INC.
 Address Box 128, Ellinwood, Kansas 67526

STATE OF KANSAS COUNTY OF BARTON
Evelyn Roth (employee of owner) or (owner-or-operator) of the above-described

well, being first duly sworn on oath, says: That I have knowledge of the facts, statements, and matters herein contained and the log of the above-described well as filed and that the same are true and correct. So help me God.

(Signature) Evelyn Roth
Ellinwood, Kansas
 (Address)

SUBSCRIBED AND SWORN TO before me this 30th day of March, 1976

JENNY KASSELMAN
 NOTARY PUBLIC
 BARTON COUNTY, KANSAS
 MY COMM. EXP. JULY 16, 1978

Jenny Kasselmann
 Notary Public.

W E L L L O G

OPERATOR: GEORGE A REED

WELL NAME: ROTHGARN #2 LOCATION: 10-21S-13W NW SW SE

COUNTY: STAFFORD STATE: KANSAS

WELL COMMENCED: 8/21/65 WELL COMPLETED: 8/31/65

ELEVATION: 1880 KB TOTAL DEPTH: 3605'

PRODUCTION: PRODUCING RIG NO: #2

CASING - 8-5/8": (8 jts.), 331' W/300 sx cement.

5-1/2": Set @3604' (114 jts.) W/40 sx req. + 70 sx 50-50 cmt.

All Measurements taken from the top of rotary bushing.

FROM	TO	FORMATION	DEVIATION FROM VERTICAL	REMARKS:
0	331	Sand	1/4° - 500'	
331	743	Red Bed	1/2° - 1000'	
743	763	Anhydrite	1/2° - 1500'	
763	1525	Shale & Shells	1/2° - 2000'	
1525	3005	Lime & Shale	1/2° - 2500'	
3005	3195	Lime	1/2° - 3000'	
3195	3320	Lime & Shale		DST #1 3309-3340'
3320	3560	Lime		DST #2 3343-3370'
3560	3605	Arbuckle		DST #3 3411-3440'
				DST #4 3452-3484'
				DST #5 3554-3560'
				DST #6 3561-3569'

RECEIVED
STAFFORD COUNTY, KANSAS

MAR 16 1976

STATE OF KANSAS
Wichita, Kansas

STATE OF KANSAS)
COUNTY OF SEDGWICK) ss:

The undersigned hereby certifies that to the best of his knowledge and belief, the above facts are true and correct.

C-G DRILLING CO.

By G. F. Galloway

SUBSCRIBED AND SWORN TO, BEFORE ME, This 7th day of January, 1966

exp: May 20, 1967

Vicky Jacobs
Vicky Jacobs - Notary Public

