

STATE OF KANSAS
STATE CORPORATION COMMISSION

WELL PLUGGING RECORD

OR

FORMATION PLUGGING RECORD

Strike out upper line
when reporting plug-
ging off formations.

Give All Information Completely
Make Required Affidavit
Mail or Deliver Report to:
Conservation Division
State Corporation Commission
800 Bitting Building
Wichita, Kansas

Stafford County. Sec. 10 Twp. 21 Rge. 13 (#) (W)

Location as "NE 1/4 NW 1/4 SW 1/4" or footage from lines SW SW SE

Lease Owner Westgate-Greenland & Mallard Drilling Co.

Lease Name Rothgarn Well No. 1

Office Address 1023 Union National Bank

Character of Well (completed as Oil, Gas or Dry Hole) Dry

Date well completed January 20 19 49

Application for plugging filed January 20 19 49

Application for plugging approved " 19 49


Plugging commenced January 20 19 49

Plugging completed " 19 49

Reason for abandonment of well or producing formation

If a producing well is abandoned, date of last production 19

Was permission obtained from the Conservation Division or its agents before plugging was commenced? yes

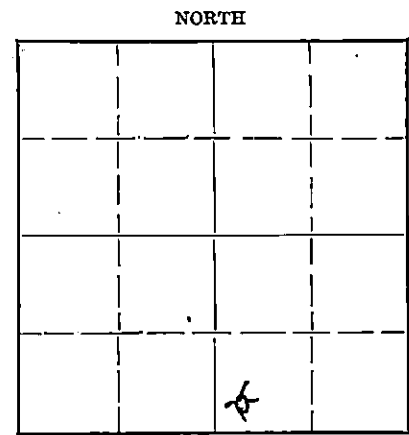

Locate well correctly on above
Section Plat

Name of Conservation Agent who supervised plugging of this well C. D. Stough

Producing formation Depth to top Bottom Total Depth of Well 3640 Feet

Show depth and thickness of all water, oil and gas formations.

OIL, GAS OR WATER RECORDS

CASING RECORD

Formation	Content	From	To	Size	Put In	Pulled Out
				8 5/8"	283'	none

Describe in detail the manner in which the well was plugged, indicating where the mud fluid was placed and the method or methods used in introducing it into the hole. If cement or other plugs were used, state the character of same and depth placed, from feet to feet for each plug set.

Filled hole full heavy mud to 283 feet of top, drove
plug to 283 ft., dumped in 20 sacks cement, finished
filling hole full heavy mud to within 15 feet of top
and dumped in 5 sacks.

1-27-49

RECEIVED
Conservation Div.
JAN 27 1949
STATE CORPORATION
COMMISSION
KANSAS

(If additional description is necessary, use BACK of this sheet)

Correspondence regarding this well should be addressed to Westgate-Greenland Oil Company
Address 1023 Union National Bank Bldg.

STATE OF Kansas, COUNTY OF Sedgwick, ss.

C. C. Nelson, partner Mallard Drg. Co. (employee of owner) or (owner or operator) of the above-described well,
being first duly sworn on oath, says: That I have knowledge of the facts, statements, and matters herein contained and the log of the above-described well as filed and that the same are true and correct. So help me God.

(Signature) C. C. Nelson

SUBSCRIBED AND SWORN to before me this 26 day of January, 1949

(Address)

Maxwell Wright
Notary Public.

My commission expires 1/24/52

22-2625 2-48-15M
PLUGGING
FILE SEC 10 T 21 R 34
BOOK PAGE 80 LINE 37

COMPANY: Westgate-Greenland Oil Company
 Contractor: Mallard Drilling Company
 Contractor: Mallard Drilling Company
 FARM: Rothgarn #1
 LOCATION: SW SW SE
 Section 10-21-13W, Stafford County, Kansas
 COMMENCED: January 6, 1949
 COMPLETED: January 20, 1949

0	to	60	Sand
60	to	260	Sand
260	to	281	Red Bed
281	to	590	Red Bed
590	to	1390	Shale and shells
1390	to	1655	Lime and shale
1655	to	1780	Lime and shale
1780	to	1975	Lime
1975	to	2830	Lime and shale
2830	to	2905	Lime
2905	to	3546	Lime
3546	to	3558	Conglomerate
3558	to	3568	Simpson
3568	to	3578	Simpson
3578	to	3598	Simpson
3598	to	3611	Simpson
3611	to	3626	Simpson
3626	to	3638	Lime--arbuckle
		3638	T.D.

Set 283 feet of 8 5/8" surface pipe. Cemented with 185 sacks cement.

TOPS; K.C.--3301 Arbuckle --3626

Measurements taken from derrick floor.

DRY, ABANDONED AND PLUGGED

C E R T I F I C A T E

I, C. C. Nelson, do hereby certify that the above and foregoing is a true and correct copy of the log of Rothgarn #1, Section 10-21-13W, Stafford County, Kansas, as reflected by files of the Mallard Drilling Company.

C. C. Nelson

Subscribed and sworn to before me a Notary public, within and for Sedgwick County, Kansas, this 26 day of January 1949.

Lawrence Wright

My commission expires 1/4/52

RECEIVED

JAN 26 1949

PLUGGING
 FILE SEC 10-21-13W
 BOOK PAGE 80 LINE 37