

STATE OF KANSAS  
STATE CORPORATION COMMISSION


WELL PLUGGING RECORD

Give All Information Completely  
Make Required Affidavit  
Mail or Deliver Report to:  
Conservation Division  
State Corporation Commission  
800 Bitting Building  
Wichita, Kansas

FORMATION PLUGGING RECORD

Strike out upper line  
when reporting plugging  
of formations.

*Stafford* County. Sec. *10* Twp. *24* Rge. *13* (W)  
Location as "NE 1/4 NW 1/4 SW 1/4" or footage from lines. *CE 1/2 SE 1/4 SE 1/4*  
Lease Owner *W.P. Faulkner*  
Lease Name *Rahgarn* Well No. *1*  
Office Address *409 First North Bank Bldg* *Wichita K.*  
Character of Well (completed as Oil, Gas or Dry Hole) *Dry*  
Date well completed *July 28* 19*43*  
Application for plugging filed *"* 19*43*  
Application for plugging approved *"* 19*43*  
Plugging commenced *"* 19*43*  
Plugging completed *July 28* 19*43*  
Reason for abandonment of well or producing formation *Dry*

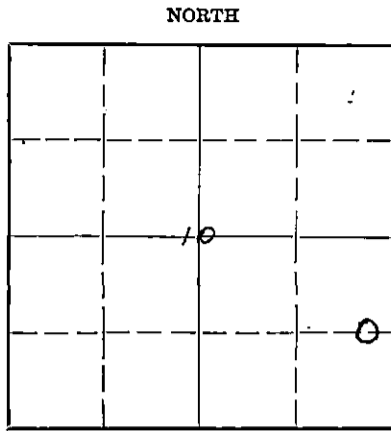

Locate well correctly on above  
Section Plat

Name of Conservation Agent who supervised plugging of this well *J.R. Stafford*  
Producing formation..... Depth to top..... Bottom..... Total Depth of Well *3750* Feet  
Show depth and thickness of all water, oil and gas formations.

OIL, GAS OR WATER RECORDS

CASING RECORD

Formation	Content	From	To	Size	Put In	Pulled Out

Describe in detail the manner in which the well was plugged, indicating where the mud fluid was placed and the method or methods used in introducing it into the hold. If cement or other plugs were used, state the character of same and depth placed, from..... feet to..... feet for each plug set.

*From 3750 to 175 Heavy Mud*  
*175 to 125 Bridgman Cement*  
*125 to 25 Heavy Mud*  
*25 to 6 Bridgman Cement*

*276 ft 10-18 Repe left in well.*

8-13-43

PLUGGING  
FILE REC-10 817130  
PAGE 84 LINE 44  
(If additional description is necessary, use BACK of this sheet)

Correspondence regarding this well should be addressed to.....  
Address *409 First North Bank Bldg* *Wichita Kans*

STATE OF *Kansas*, COUNTY OF *Sedgewick*, ss.  
*W.P. Faulkner* (employee of owner) or (owner or operator) of the above-described well,

being first duly sworn on oath, says: That I have knowledge of the facts, statements, and matters herein contained and the log of the above-described well as filed and that the same are true and correct. So help me God.

(Signature) *W.P. Faulkner*  
*409 First North Bk Bldg* (Address) *Wichita K.*

SUBSCRIBED AND SWORN to before me this *12th* day of *August*, 19*43*  
*Mildred J. Jaeger* Notary Public.

My commission expires *May 5, 1945*

LOG

REHEARN "B" 1 - 10-21-1911, STAFFORD CO., KANSAS  
 C E/2 SE SE  
 Elevation 1878

0-70 Surface Soil, sand & gravel  
 125 Iron Pyrite  
 210 Clay & shale  
 270 Sand  
 280 Shale Set 280'. 10.3/4" Casing  
 364 Red Bed & sand  
 734 Red Bed & Shale  
 754 Anhydrite  
 760 Shale  
 1148 Shale & Shells  
 1392 Red Bed, shale & shells  
 1593 Shale & lime shells  
 1695 Lime  
 1764 Shale & lime  
 1860 Lime  
 1912 Lime & shale  
 2038 Lime  
 2098 Shale streaks & lime  
 2192 Lime  
 2273 Shale & lime  
 3158 Lime  
 3258 Lime & shale  
 3532 Lime  
 3567 Lime & shale  
 3609 Lime & Conglomerate  
 3649 Shale & Conglomerate  
 3682 Conglomerate  
 3721 Conglomerate & chert  
 3750 Shale & chert T.D.

Filled hole to 175 Heavy Mud  
 Cement Bridge 125 to 175  
 Cement Bridge 25 to top

10 21 (3W)  
 84. . . 44