

WELL PLUGGING RECORD

OR

FORMATION PLUGGING RECORD

Strike out upper line when reporting plugging of formations.

STATE OF KANSAS
STATE CORPORATION COMMISSION

Give All Information Completely
Make Required Affidavit
Mail or Deliver Report to:
Conservation Division
State Corporation Commission
800 Bittling Building
Wichita, Kansas

Stafford County, Sec. 9 Twp. 22S Rge. 12 (W)

Location as "NE $\frac{1}{4}$ NW $\frac{1}{4}$ SW $\frac{1}{4}$ " or footage from lines SW SW NE

Lease Owner Petroleum, Inc.

Lease Name AHNERT Well No. 1

Office Address 100 Derby Building, Wichita 2, Kansas

Character of Well (completed as Oil, Gas or Dry Hole) dry hole

Date well completed April 20, 1950

Application for plugging filed May 3, 1950

Application for plugging approved April 26, 1950


Plugging commenced April 20, 1950

Plugging completed April 20, 1950

Reason for abandonment of well or producing formation dry hole

If a producing well is abandoned, date of last production _____ 19____

Was permission obtained from the Conservation Division or its agents before plugging was commenced? yes

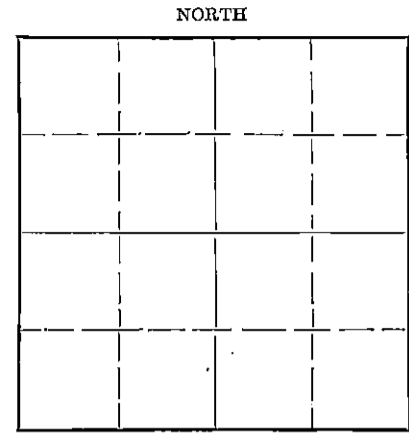

Locate well correctly on above Section Plat

Name of Conservation Agent who supervised plugging of this well C. D. Stough

Producing formation _____ Depth to top _____ Bottom _____ Total Depth of Well 3694 Feet

Show depth and thickness of all water, oil and gas formations.

OIL, GAS OR WATER RECORDS

CASING RECORD

Formation	Content	From	To	Size	Put In	Pulled Out
				8" 5/8"	242'	

Describe in detail the manner in which the well was plugged, indicating where the mud fluid was placed and the method or methods used in introducing it into the hole. If cement or other plugs were used, state the character of same and depth placed, from _____ feet to _____ feet for each plug set.

Plug placed at 242', 15 sacks of cement placed on top of plug through drill pipe. Hole filled with heavy mud to 30', 10 sacks of cement placed on top of plug at 30'.

(If additional description is necessary, use BACK of this sheet)

Correspondence regarding this well should be addressed to Petroleum, Inc.
Address 100 Derby Building, Wichita, Kansas


STATE OF KANSAS, COUNTY OF SEDGWICK, SS.
Eric H. Jager (employee of owner ~~XXXXXXXXXXXX~~) of the above-described well, being first duly sworn on oath, says: That I have knowledge of the facts, statements, and matters herein contained and the log of the above-described well as filed and that the same are true and correct. So help me God.

(Signature) Eric H. Jager
Executive Vice-President
100 Derby Building, Wichita, Kansas
(Address)

SUBSCRIBED AND SWORN to before me this 3rd day of May, 1950

Marjorie Bradshaw
Notary Public.

My commission expires October 27, 1952.

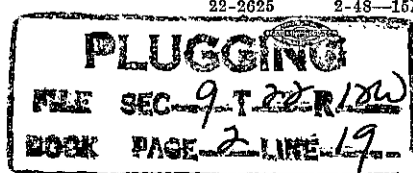

MAY 6 - 1950
5-6-50
KANSAS

MINERT WELL #1

Casing Record:

8" - 242'

COMPANY: Petroleum, Inc., and
Aylward Drilling Company

CONTRACTOR: Aylward Drilling Company

COMMENCED: April 9, 1950
COMPLETED: April 20, 1950

Description:

SW/4 SW/4 NE/4 of
Sec. 9-22S-12W
Stafford Co., Kansas

Elevation:

Production: D. & A.

<u>Formation</u>	<u>From</u>	<u>To</u>	<u>Remarks</u>
Surface Clay	0	25	
Sand	25	200	
Red Rock	200	665	Set 8" casing at 242' and cemented with 150 sacks
Anhydrite	665	690	
Shale and shells	690	1170	
Shale and salt	1170	1400	
Shale and lime shells	1400	1500	
Shale, shells and broken lime	1500	1715	
Shale and shells	1715	1740	
Lime	1740	2135	
Lime and shale	2135	2390	
Shale	2390	2520	
Shale and shells	2520	2670	
Shale and lime	2670	2905	
Lime	2905	3205	
Lime and shale	3205	3340	
Lime	3340	3550	
Lime cherty and shale	3550	3578	
Lime and shale	3578	3580	
Lime and chert	3580	3650	
Lime and sand	3650	3689	
Lime	3689	3694	

T. D. 3694

D. S. T. 3690' to 3694', 4' of anchor, open 45 Min. weak diminishing blow
30 Min. - recovered 45' thin mud, strong sulphur odor, B. G. P. 1110# in 15 Min.

Formation Tops:

Viola 3579'
Simpson 3632'
Arbuckle 3689'

I certify that this is a true and correct copy of the above log to the best of my knowledge.

J. P. Skalsky
J. P. Skalsky

Subscribed and sworn to before me this 25th day of April, 1950.

Henry Cooper
HENRY COOPER
NOTARY PUBLIC

My commission expires
July 16, 1952.

