

WELL PLUGGING RECORD

OR


FORMATION PLUGGING RECORD

Strike out upper line when reporting plugging off formations.

STATE OF KANSAS
STATE CORPORATION COMMISSION

Give All Information Completely
Make Required Affidavit
Mail or Deliver Report to:
Conservation Division
State Corporation Commission
800 Bitting Building
Wichita, Kansas

Stafford County. Sec. 9 Twp. 22 Rge. 12 (E) W (W)
Location as "NE 1/4 NW 1/4 SW 1/4" or footage from lines. NE cn NE 1/4
Lease Owner. Bishop Oil Company, et al
Lease Name. Ahnert Well No. 1
Office Address. 316 Brown Bldg., Wichita, Kansas
Character of Well (completed as Oil, Gas or Dry Hole). Dry Hole
Date well completed. Dec. 11, 1949
Application for plugging filed. Feb. 2
Application for plugging approved. Feb. 2
Plugging commenced. Feb. 3
Plugging completed. Feb. 7
Reason for abandonment of well or producing formation. Dry
If a producing well is abandoned, date of last production. 19
Was permission obtained from the Conservation Division or its agents before plugging was commenced? Yes

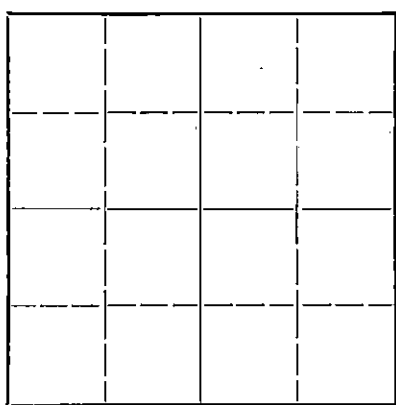

Locate well correctly on above Section Plat

Name of Conservation Agent who supervised plugging of this well. C. D. Stough
Producing formation. Depth to top. 3662 Bottom. 3701 Total Depth of Well. 3701 Feet
Show depth and thickness of all water, oil and gas formations.

OIL, GAS OR WATER RECORDS

CASING RECORD

Formation	Content	From	To	Size	Put In	Pulled Out
				8 5/8"	260/150 sk	None
				5 1/2"	3662/125 sk	:

Describe in detail the manner in which the well was plugged, indicating where the mud fluid was placed and the method or methods used in introducing it into the hold. If cement or other plugs were used, state the character of same and depth placed, from feet to feet for each plug set.

3650' to 3701' Mud. Put in with bailer
3650' to 3648' Wood plug and rock bridge
3648' to 3608' 5 sks cement run in dump bailer
3608' to 230' Mud. Put in through 8 5/8 casing
230' to 220' 10' rock bridge
220' to 160' 15 sks cement - run in bailer
160' to 40' Mud. Set 5' rock bridge
35' to top 10 sks cement

RECEIVED
Conservation Div.
FEB 16 1950
STATE CORPORATION
COMMISSION
KANSAS

2-16-50

(If additional description is necessary, use BACK of this sheet)

Correspondence regarding this well should be addressed to. Bishop Oil Company
Address. 316 Brown Bldg., Wichita, Kansas

STATE OF Kansas COUNTY OF Sedgwick, ss.

Carl Todd (employee of owner) or (owner or operator) of the above-described well, being first duly sworn on oath, says: That I have knowledge of the facts, statements, and matters herein contained and the log of the above-described well as filed and that the same are true and correct. So help me God.

(Signature) Carl Todd
Chief Geologist, Mid-Continent Area
316 Brown Bldg., Wichita, Kansas

SUBSCRIBED AND SWORN to before me this 15 day of February, 1950

My commission expires October 5, 1953

Luille A. Barenberg
Notary Public.

PLUGGING
FILE SEC 9T 22R 12D
BOOK PAGE 137 LINE 10

AHMERT #1

Casing Records:

8" - 260'

5" - 3662'

COMPANY: AYLWARD DRILLING CO.
AND BISHOP OIL CO.

CONTRACTOR: AYLWARD DRILLING COMPANY

COMMENCED: November 9, 1949

COMPLETED: December 11, 1949

Description:

NEcn NE/4 of Section
9-22S-12W, Stafford
County, Kansas.

Elevation: 1862 R.B.

Production: T.A.

<u>Formation:</u>	<u>From</u>	<u>To</u>	<u>Remarks</u>
Sand and clay	0	40	
Sand	40	185	
Shale Red	185	500	Set 8-5/8" Casing at 260' and cemented w/150 sax.
Red Bed and shale	500	622	
Anhydrite	622	650	
Shale and shells	650	960	
Gyp and Anhydrite	960	995	
Shale and shells	995	1205	
Salt	1205	1400	
Shale and shells	1400	1530	
Shale and lime	1530	1920	
Lime	1920	1960	
Lime and shale	1960	2430	
Shale and shells	2430	2500	
Shale	2500	2540	
Shale and lime shells	2540	2615	
Lime and shale	2615	2665	
Shale and shells	2665	2740	
Shale and lime	2740	2885	
Shale and shells	2885	2905	
Lime and shale	2905	3090	
Lime	3090	3190	
Lime and shale	3190	3290	
Lime	3290	3445	
Lime cherty	3445	3470	
Lime	3470	3547	
Lime and shale	3547	3553	
Cherty lime and shale	3553	3598	
Cherty lime	3598	3634	
Lime and shale	3634	3661	5 1/2" set at 3662' & cemented w/125 sax.
Lime	3661	3701 T.D.	

TOPS:

Heebner 3153'
 Toronto 3173'
 Brown Lime 3289'
 Lansing 3309 - 1447'
 Viola 3556'
 Simpson 3604'
 Arbuckle 3661'

D.S.T. #1 - 3317-55', open 45 mi. rec. 25', very slightly cut mud, No. B.H.P.
 D.S.T. #2 - 3359-3420', open 1 hr. rec. 45' mud - 900# B.H.P.
 D.S.T. #3 - 3430-3504', open 1 hr. rec. 63' mud, slight oil cut.

KANSAS

I certify that this is a true and correct copy of the above log to the best of my knowledge.

FEB 2 X 1950

Al Skalsky

Subscribed and sworn to before me this 14th day of December, 1949.

My commission expires
July 16, 1952.