


STATE OF KANSAS
STATE CORPORATION COMMISSION

WELL PLUGGING RECORD

Give All Information Completely
Make Required Affidavit
Mail or Deliver Report to:
Conservation Division
State Corporation Commission
800 Bitting Building
Wichita, Kansas

Stafford County. Sec. 24 Twp. 22 Rge. 12 ~~7~~ (W)
Location as "NE/CNW 1/4 SW 1/4" or footage from lines ~~CE 1/2 NW 1/4 SW 1/4~~
Lease Owner Lotus Oil Co.
Lease Name Heyen "C" Well No. 1
Office Address 900 Land Bank Bldg., Kansas City, Mo.
Character of Well (completed as Oil, Gas or Dry Hole) Oil Well
Date well completed..... 19.....
Application for plugging filed..... 19.....
Application for plugging approved..... 19.....
Plugging commenced 1/29/52..... 19.....
Plugging completed 2/4/52..... 19.....
Reason for abandonment of well or producing formation Depleted
If a producing well is abandoned, date of last production..... 19.....
Was permission obtained from the Conservation Division or its agents before plugging was commenced? Yes

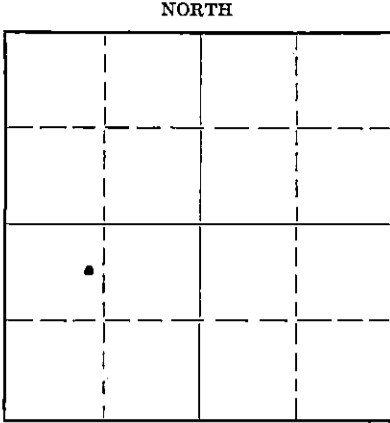

Locate well correctly on above Section Plat

Name of Conservation Agent who supervised plugging of this well C. D. Stough
Producing formation Arbuckle Depth to top..... Bottom..... Total Depth of Well 3652 Feet
Show depth and thickness of all water, oil and gas formations.

OIL, GAS OR WATER RECORDS

CASING RECORD

Formation	Content	From	To	Size	Put In	Pulled Out
		0	215'	10 3/4" O. D.	215	None
		0	3647'	5 1/2" O. D.	3647'	2915.35'

Describe in detail the manner in which the well was plugged, indicating where the mud fluid was placed and the method or methods used in introducing it into the hole. If cement or other plugs were used, state the character of same and depth placed, from.....feet to.....feet for each plug set.

Total Depth 3652'
Rock 3652'-3640'
3640'-3605' 5 sks. cement
3605'-215' Heavy Mud
215'-210' Rock Bridge
210'-170' 20 sks. cement
170'-30' Heavy Mud
30'-base of cellar 10 sks. cement

2-6-52

RECEIVED
FEB 6 X 1952
CONSERVATION DIVISION
Wichita, Kansas

(If additional description is necessary, use BACK of this sheet)

Correspondence regarding this well should be addressed to.....
Address.....

STATE OF Kansas, COUNTY OF Reno, ss.
Walker Drilling Inc. (employee of owner) or (owner or operator) of the above-described well,
being first duly sworn on oath, says: That I have knowledge of the facts, statements, and matters herein contained and the log of the above-described well as filed and that the same are true and correct. So help me God. Walker Drilling Inc.

(Signature) R. S. Walker
Hutchinson, Kansas (Address)

SUBSCRIBED AND SWORN to before me this 5th day of February, 1952

B. A. Carhart Notary Public.

My commission expires My Commission Expires, Jan. 26, 1954
22-7377-5 4-49-10M

FILED
FEB 24 1952
BOOK PAGE 129 LINE 46


WELL LOG BUREAU — KANSAS GEOLOGICAL SOCIETY
412 Union National Bk. Bldg., Wichita, Kansas

Company - H.A. HERSHFIELD & CO., INC.
Farm - Heyen "C" No. 1.

SEC. 24 T. 22 R. 12 W
CE 1/2 NW SW

Total Depth. 3652
Comm. 7-15-45 Comp. 8-6-45
Shot or Treated.
Contractor. Pulse-Hershfield Drig. Co., Inc.
Issued. 10-13-45

County. Stafford
KANSAS

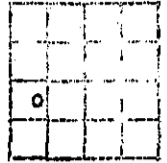

CASING:
10 3/4" 215' Cem.
5 1/2" 3647' Cem.

Elevation. _____

Production. Pot. 144 plus
2 % Wtr.

Figures indicate Bottom of Formations.

surface & sand	165
clay	197
red bed & shells	595
anhydrite	615
shale red & shells	970
shale	1230
salt & shale	1284
shale & shells	1510
lime brkn	1677
lime sdy	1745
lime	1802
lime sdy	1864
lime	2048
shale & shells	2614
lime	2687
shale & shells	2759
lime	2800
shale & shells	2835
lime	3164
shale & shells	3207
shale	3270
lime	3515
shale	3550
lime cherty	3592
Simpson shale	3647
sand	3650
lime Arbuckle	3652
Total Depth	

24 28 180
129 516

RECEIVED
STATE CONSERVATION COMMISSION
DEC - 7 1951
CONSERVATION DIVISION
Wichita, Kansas