


STATE OF KANSAS
STATE CORPORATION COMMISSION

Give All Information Completely
Make Required Affidavit
Mail or Deliver Report to:
Conservation Division
State Corporation Commission
211 No. Broadway
Wichita, Kansas

WELL PLUGGING RECORD

NORTH

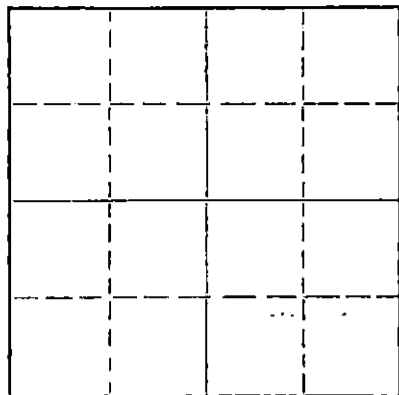

Locate well correctly on above
Section Flat

Pawnee County, Sec. 27 Twp. 22S Rge. 15 (X) W (W)
Location as "NE/CNW/SWK" or footage from lines NW NW SW
Lease Owner Emil B. Kucera
Lease Name McComas Well No. 1
Office Address Box 201, Vermillion, South Dakota
Character of Well (completed as Oil, Gas or Dry Hole) Dry Hole
Date well completed June 12 19 59
Application for plugging filed June 12 19 59
Application for plugging approved June 12 19 59
Plugging commenced June 12 19 59
Plugging completed June 12 19 59
Reason for abandonment of well or producing formation Dry Hole

If a producing well is abandoned, date of last production _____ 19____
Was permission obtained from the Conservation Division or its agents before plugging was commenced? Yes

Name of Conservation Agent who supervised plugging of this well Frank Brandford
Producing formation _____ Depth to top _____ Bottom _____ Total Depth of Well 4060 Feet
Show depth and thickness of all water, oil and gas formations.

OIL, GAS OR WATER RECORDS

CASING RECORD

FORMATION	CONTENT	FROM	TO	SIZE	PUT IN	PULLED OUT

Describe in detail the manner in which the well was plugged, indicating where the mud fluid was placed and the method or methods used in introducing it into the hole. If cement or other plugs were used, state the character of same and depth placed, from _____ feet to _____ feet for each plug set.

8 5/8" SP - 259' Cemented with 250 Sacks.

Filled hole with mud to 245' Set plug with 1/4 sack hulls. 23 sacks cement through drill pipe. Filled with mud to 35' and set plug with hulls. Capped to base of cellar with 10 sacks.

RECEIVED
STATE CORPORATION COMMISSION
AUG 17 1959
CONSERVATION DIVISION
Wichita, Kansas

(If additional description is necessary, use BACK of this sheet)

Name of Plugging Contractor Bergman Drilling, Inc.
Address 425 Union Center Bldg., Wichita, Kansas

STATE OF Kansas, COUNTY OF Sedgwick, ss.
Harold Bergman (owner) of the above-described well, being first duly sworn on oath, says: That I have knowledge of the facts, statements, and matters herein contained and the log of the above-described well as filed and that the same are true and correct. So help me God.

(Signature) Harold Bergman
425 Union Center Bldg., Wichita, Kansas
(Address)

SUBSCRIBED AND SWORN TO before me this 16th day of June, 19 59

My commission expires My Commission Expires September 25, 1960 Notary Public.

PLUGGING
FILE SEC. 27 T. 22 R. 15W
BOOK PAGE 58 LINE 34

WELL LOG

15-145-19034-0000

DATE STARTED: May 29, 1959
DATE COMPLETED: June 12, 1959

#1 May McComas
NW NW SW
Sec. 27-22S-15W
Pawnee County, Kansas

0- 165 Surface sand, Clay & Shale
165- 258 Shale Shells
258- 400 Shale Shells
400- 526 Sand
526- 970 Red Bed Shale
970-1515 Shale - Shells
1515-1820 Shale & Shells
1820-1890 Shale - Shells
1890-1950 Lime Shale
1950-2100 Lime
2100-2220 Lime Shale
2220-2370 Lime - Shale
2370-2515 Lime & Shale
2515-2700 Lime & Shale
2700-2845 Shale - Lime
2845-2945 Shale & Lime
2945-3115 Shale & Lime
3115-3245 Shale - Lime
3245-3320 Shale & Lime
3320-3410 Lime & Shale
3410-3475 Lime
3475-3540 Lime
3540-3670 Lime
3670-3627 Lime
3627-3688 Lime
3688-3725 Lime
3725-3773 Lime
3773-3825 Lime
3825-3870 Lime & Shale
3870-3900 Lime - Shale
3900-3968 Shale Cong. Lime Cherty
3968-3990 Lime Shale & Chert
3990-4021 Lime Shale Chert
4021-4050 Shale Sand & Lime Chert
4050-4060 Shale
4060 Total Depth

TOPS
Elevation 1999KB
Heebner Shale 3436
Iotan Lime 3559
Lansing Kansas City 3569
Viola 3937
Simpson 3986
Conglomerate 4030
TD 4060

RECEIVED
STATE CORPORATION COMMISSION

AUG 17 1959

CONSERVATION DIVISION
Wichita, Kansas

AFFIDAVIT

STATE OF KANSAS

SEDGWICK COUNTY,

I, do swear that the statements and matter herein contained are true to the best of my knowledge.

Subscribed and sworn before me this 16th
day of June, 1959.

BERGMAN DRILLING, INC.

My Commission expires September 25, 1960

My Commission expires:

Betty Sloan
Notary Public

Harold Bergman