


WELL PLUGGING RECORD

Give All Information Completely
Make Required Affidavit
Mail or Deliver Report to:
Conservation Division
State Corporation Commission
211 No. Broadway
Wichita, Kansas

Pawnee County, Sec. 27 Twp. 22 Rge. 15 (E) W (W)

Location as "NE/CNW/SW" or footage from lines NE NE NW
Lease Owner Great Bend Pipe & Supply Company, Inc.
Lease Name Sutton Well No. 1
Office Address Great Bend, Kansas
Character of Well (completed as Oil, Gas or Dry Hole) _____
Date well completed _____ 19____
Application for plugging filed _____ 19____
Application for plugging approved _____ 19____
Plugging commenced 1-6-65 _____ 19____
Plugging completed 1-14-65 _____ 19____
Reason for abandonment of well or producing formation Depleted.

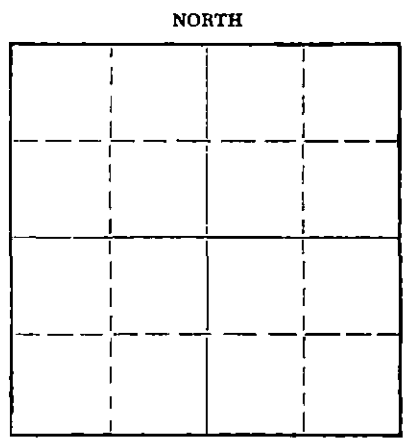

If a producing well is abandoned, date of last production _____ 19____
Was permission obtained from the Conservation Division or its agents before plugging was commenced? yes

Name of Conservation Agent who supervised plugging of this well Eldon Petty
Producing formation _____ Depth to top _____ Bottom _____ Total Depth of Well 3992 Feet
Show depth and thickness of all water, oil and gas formations.

OIL, GAS OR WATER RECORDS

CASING RECORD

FORMATION	CONTENT	FROM	TO	SIZE	PUT IN	PULLED OUT
				8-5/8"	224'	None
				5-1/2"	3989'	3474'

Describe in detail the manner in which the well was plugged, indicating where the mud fluid was placed and the method or methods used in introducing it into the hole. If cement or other plugs were used, state the character of same and depth placed, from _____ feet to _____ feet for each plug set.

Checked hole to 3992', sanded to 3965' and dumped 4 sacks of cement @ 3965' with dump bailer. Pulled 5 1/2" casing to 550' and circulated with 20 sacks of gel mud. Pulled 5 1/2" casing to 350' and pumped in 20 sacks of cement @ 350'. Pulled casing to 180' and pumped in 20 sacks of cement. Pulled balance of 5 1/2" casing, bailed fluid and ran 10 sacks of cement to base of cellar.

RECEIVED
STATE CORPORATION COMMISSION

JAN 26 1965

PLUGGING COMPLETE.

CONSERVATION DIVISION
Wichita, Kansas

(If additional description is necessary, use BACK of this sheet)
Name of Plugging Contractor KNIGHT CASING PULLING COMPANY
Address CHASE, KANSAS

STATE OF KANSAS COUNTY OF RICE, ss.
Noel J. Knight (employee of owner) or (conservation agent) of the above-described well, being first duly sworn on oath, says: That I have knowledge of the facts, statements, and matters herein contained and the log of the above-described well as filed and that the same are true and correct. So help me God.

(Signature) Earl J. Knight
Chase, Kansas
(Address)

SUBSCRIBED AND SWORN TO before me this 22nd day of January 1965

My commission expires May 20, 1968
Milton J. Volin Notary Public.

DRILLERS' LOG

COMPANY: Westgate-Greenland Oil Company
 Cities Service Oil Company

CONTRACTOR: Westgate Drilling Corporation

FARM: Sutton #1 NE NE NW Sec. 27-22-15W,
 Pawnee County, Kansas

COMMENCED: March 2, 1953 - Rotary
 March 17, 1953 - Cardwell

COMPLETED: March 14, 1953 - Rotary
 March 18, 1953 - Cardwell

ELEVATION: 1993 BP

0	to	120	Clay and sand
120	to	425	Shale and shells
425	to	550	Red bed and sand
550	to	945	Red bed and shells
945	to	980	Anhydrite
980	to	1570	Shale, shells and salt
1570	to	1820	Shale and shells
1820	to	1859	Lime and shale
1859	to	2041	Lime
2041	to	3280	Lime and shale
3280	to	3305	Lime
3305	to	3340	Lime and shale
3340	to	3405	Lime
3405	to	3526	Shale and lime
3526	to	3785	Lime
3785	to	3865	Lime, shale and chert
3865	to	3927	Lime and shale
3927	to	3938	Shale and sandy lime
3938	to	3978	Lime and shale
3978	to	3992	T. D. (RB)

RECEIVED
 STATE CORPORATION COMMISSION
 DEC 31 1964
 CONSERVATION DIVISION 4
 Wichita, Kansas

Set 224' of 8 5/8" surface pipe. Cemented with 200 sacks cement and 3 calcium chloride.

Set 5 1/2" 15 1/2# casing at 3989 (DF). Cemented with 75 sx cement.

TOPS: Anhydrite 943. Lansing 3534 Simpson 3925
 Heebner 3400 Viola 3875 Arbuckle 3977
 Brown Ls 3524

DRILL STEM TESTS:

3673-3713, 1 hour, rec. 160' muddy salt water, 1160# BHP.
 3978-84, open 1 hr, rec. 2100' oil, 30' HO&GCM, 1240# BHP.
 IFP 190#, FFP 750#.
 3984-90, open 1 hr, rec. 900' gas, 1320' oil, 60' HO&GCM.
 OFP 220#, FFP 560#, BHP 1230#.

Schlumberger run

Perf. 42 holes 3976-84, 18 holes 3986-90, filled up 800' first hour, 2100' in 3 hours. Swabbed 120 BO in 6 hours, natural.
 Filed 25 BOFD Temporary Productivity Affidavit as of 3/18/53
 POTENTIAL: 640 barrels

C E R T I F I C A T E

I, Don Allen, do hereby certify that the above and foregoing is a true and correct copy of the log of Sutton #1, NE NE NW of Section 27-22S-15W, Pawnee County, Kansas as reflected by files of the Westgate-Greenland Oil Co.

Don Allen
 Don Allen

Subscribed and sworn to before me, a Notary Public, within and for Sedgewick County, Kansas, this 20th day of March, 1953.

Esther Unsell
 Esther Unsell, Notary Public
 My commission expires May 31, 1955