


WELL PLUGGING RECORD

Give All Information Completely
Make Required Affidavit
Mail or Deliver Report to:
Conservation Division
State Corporation Commission
211 No. Broadway
Wichita, Kansas

Stafford County, Sec. 35 Twp. 22 Rge. 12W (X) (W)

Location as "NE/CNWxSWx" or footage from lines SE NW NE
Lease Owner Vaughan Drilling Inc.
Lease Name McCine Well No. 1
Office Address Box 825
Character of Well (completed as Oil, Gas or Dry Hole) Dry hole
Date well completed April 28 1963
Application for plugging filed 19
Application for plugging approved 19
Plugging commenced ~~XX~~ 2:50 a.m., April 28, 1963
Plugging completed 8:30 a.m., April 28, 1963
Reason for abandonment of well or producing formation Dry Hole

NORTH

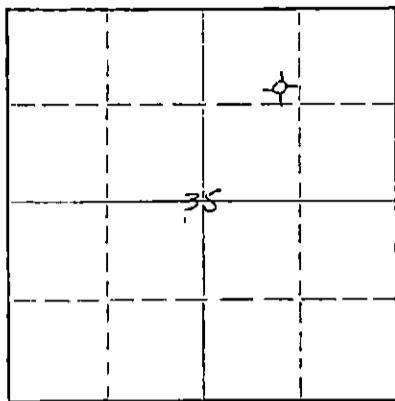

Locate well correctly on above Section Plat

If a producing well is abandoned, date of last production 19
Was permission obtained from the Conservation Division or its agents before plugging was commenced? yes

Name of Conservation Agent who supervised plugging of this well Archie V. Elvins
Producing formation _____ Depth to top _____ Bottom _____ Total Depth of Well 3695 Feet
Show depth and thickness of all water, oil and gas formations.

OIL, GAS OR WATER RECORDS

CASING RECORD

FORMATION	CONTENT	FROM	TO	SIZE	PUT IN	PULLED OUT
		0'	241'	8 5/8"	241'	none

Describe in detail the manner in which the well was plugged, indicating where the mud fluid was placed and the method or methods used in introducing it into the hole. If cement or other plugs were used, state the character of same and depth placed, from _____ feet to _____ feet for each plug set.
Bottom plug @ 180' with 1/4 sack hulls & 20 sax cement.
Top plug @ 35' with 1 sack hulls and 8 sax cement. 2 sacks of cement in rat hole.

RECEIVED
STATE CORPORATION COMMISSION

MAY 3 1963

CONSERVATION DIVISION
Wichita, Kansas

(If additional description is necessary, use BACK of this sheet)

Name of Plugging Contractor Vaughan Drilling, Inc.
Address Box 825, Great Bend, Kansas

STATE OF Kansas, COUNTY OF Barton, ss.
Donald D. Vaughan (employee of owner) or (owner or operator) of the above-described well, being first duly sworn on oath, says: That I have knowledge of the facts, statements, and matters herein contained and the log of the above-described well as filed and that the same are true and correct. So help me God.

(Signature) Donald D. Vaughan
Box 825, Great Bend, Kansas
(Address)

SUBSCRIBED AND SWORN TO before me this 1 day of May, 1963

My commission expires Oct. 4, 1966

Kathryn M. Boxberger
Kathryn M. Boxberger Notary Public.

WELL LOG

COMPANY Vaughan Drilling, Inc.
 CONTRACTOR Vaughan Drilling, Inc.
 FARM McCune #1
 LOCATION SE NW NE of sec. 35-22-12W
 Stafford County, Kansas
 ELEVATION 1832 K. B.
 SURFACE PIPE 8 5/8" cemented @ 241' w/210 sax of posmix sunset.
 PRODUCTION D & A
 COMMENCED April 17, 1963
 COMPLETED April 28, 1963

<u>FORMATION</u>	<u>DEPTH</u>
Sandstone & Clay	151'
Red Clay	185'
Clay & Shale - Red Bed	241
Red Bed	568
Anhydrite	592
Red Bed & Shale	710
Blue Shale	1320
Shale	1400
Blue Shale	1485
Limestone & Shale	1870
Limestone	1985
Limestone & Shale	3000
Limestone	3080
Limestone & Shale	3240
Limestone	3325
Limestone & Shale	3350
Limestone	3435
Limestone & Shale	3475
Limestone	3536
Limestone & Shale	3589
Limestone	3591
Shale	3605
Shale & Limestone	3690
Arbuckle	3695

COPY

RECEIVED
 STATE CORPORATION COMMISSION

MAY 3 1963

CONSERVATION DIVISION
 Wichita, Kansas

FORMATION TOPS

Anhydrite	592 (+1240)
Topeka	2805 (- 973)
Heebner	3104 (-1272)
Brown Lime	3241 (-1409)
Lansing	3259 (-1427)
Arbuckle	3695 (-1863)
RTD	3695 (-1863)

A F F I D A V I T

STATE OF KANSAS, COUNTY OF BARTON, SS

I, Donald D. Vaughan, of the VAUGHAN DRILLING INC., being first duly sworn on oath, state; that I have knowledge of the facts, statements and matters herein contained and that the same are true and correct

Subscribed and sworn to before me this 2nd day of May, 1963

Kathryn M. Boxberger
 Kathryn M. Boxberger, (Notary Public)

My commission expires Oct. 4, 1966.