


STATE OF KANSAS  
STATE CORPORATION COMMISSION

WELL PLUGGING RECORD

Give All Information Completely  
Make Required Affidavit  
Mail or Deliver Report to  
Conservation Division  
State Corporation Comm.  
245 North Water  
Wichita, KS 67202

Stafford County, Sec. 35 Twp. 22S Rge. 12 R/W  
Location as "NE/CNW $\frac{1}{4}$ SW $\frac{1}{4}$ " or footage from lines  
SE NW SE

Lease Owner Mustang Drilling & Exploration, Inc.  
Lease Name McCune Well No. 1  
Office Address P.O. Drawer 1609, Gt. Bend, Kansas 67530  
Character of Well (Completed as Oil, Gas or Dry Hole)  
Dry Hole

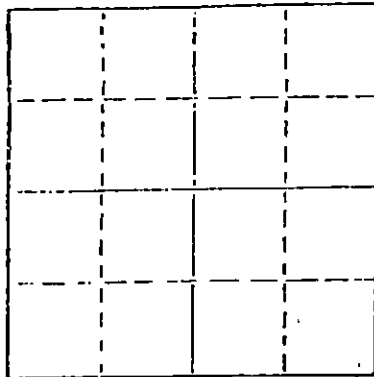

Locate well correctly on above  
Section Plat

Date Well completed November 20 1981  
Application for plugging filed November 20 1981  
Application for plugging approved November 20 1981  
Plugging commenced November 20 1981  
Plugging completed November 20 1981  
Reason for abandonment of well or producing formation

D & A  
If a producing well is abandoned, date of last production 19.

Was permission obtained from the Conservation Division or  
its agents before plugging was commenced? yes

Name of Conservation Agent who supervised plugging of this well J.H. Metz, Stafford, Kansas  
Producing formation Depth to top Bottom Total Depth of Well 3780  
Show depth and thickness of all water, oil and gas formations.

OIL, GAS OR WATER RECORDS

CASING RECORD

FORMATION	CONTENT	FROM	TO	SIZE	PUT IN	PULLED OUT
				8 5/8	401'	none

Describe in detail the manner in which the well was plugged, indicating where the mud fluid  
was placed and the method or methods used in introducing it into the hold. If cement or other  
plugs were used, state the character of same and depth placed, from feet to  
feet for each plug set.

500' w/60sx  
240' w/40 sx  
40' w/10 sx  
10sx rathole  
3 sx waterwell

(If additional description is necessary, use BACK of this sheet)

Name of Plugging Contractor Mustang Drilling & Exploration, Inc.


STATE OF Kansas COUNTY OF Barton, ss.  
Kenneth Roach (employee of owner) or (owner or operator)  
of the above-described well, being first duly sworn on oath, says: That I have knowledge of  
the facts, statements, and matters herein contained and the log of the above-described well  
as filed and that the same are true and correct. So help me God.

(Signature) Kenneth Roach  
P.O. Drawer 1609, Great Bend, Ks 67530  
(Address)

SUBSCRIBED AND SWORN TO before me this 30th day of November, 19 81

Beverly Sheewe  
Notary Public.

My commission expires

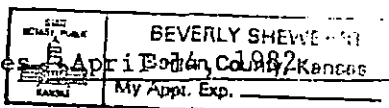

RECEIVED  
STATE CORPORATION COMMISSION

DEC - 1 1981

CONSERVATION DIVISION  
Wichita, Kansas

DRILLERS' WELL LOG

OPERATOR: Mustang Drilling & Exploration, Inc.  
 P.O. Drawer 1609, Great Bend, Kansas 67530

WELL: McCune #1

API # 15-185 - 21,377-0000

LOCATION: SE NW SE

Sec 35 -T 22 S-R 12W

COMMENCED: 11-12-81

COMPLETED: 11-20-81

ELEVATION: GL: 1828 DF: 1830 KB: 1833

TOTAL DEPTH: 3780'

CASING: Surface: 8 5/8"; 24 #; set at 401 feet;  
 Cemented with 250 sacks Commoncement; 3% cc ; 2% gel

Production: ; #; set at feet;  
 Cemented with sacks cement;

DEPTH:	FORMATION	FORMATION TOPS		
0 - 401	Sand, Red bed	Topeka	2799	-966
401 -1580	Shale	Heebner	3106	-1273
1580 -2799	Lime, Shale	Toronto	3126	-1299
2799 -3106	Lime	Douglas	3143	-1310
3106 -3110	Shale	Brown Lime	3246	-1413
3110 -3143	Lime	Lansing	3271	-1438
3143 -3246	Shale	Base KC	3526	-1693
3246 -3271	Lime, Shale	Viola	3544	-1711
3271 -3526	Lime	Simpson Shale	3622	-1789
3526 -3544	Lime, Shale	Simpson Sand	3643	-1810
3544 -3622	Lime	Arbuckle	3674	-1841
3622 -3643	Shale	RTD	3780	-1947
3643 -3674	Sand	LTD	3780	-1947
3674 -3780	Dolomite			
3780	RTD			
3780	LTD			

ACKNOWLEDGEMENT

STATE OF KANSAS, COUNTY OF BARTON, ss:

RECEIVED  
 STATE CORPORATION COMMISSION

Before me, the undersigned, a Notary Public, within and for  
 said county and state, on this 30th day of November, 1981,  
 personally appeared Kenneth Roach to me personally known  
 to be the identical person who executed the within and foregoing instrument  
 and acknowledged to me that he executed the same as his free and voluntary  
 deed for the uses and purposes therein set forth.

DEC - 1 1981

CONSERVATION DIVISION  
 Wichita, Kansas

Subscribed and sworn to before me this 30th day of November,  
 1981.

Kenneth Roach  
Beverly Shewbart  
 Notary Public

My Appointment Expires:  
 April 1982, 1982 Exp.  
 BEVERLY SHEWBART  
 Barton County, Kansas