


WELL PLUGGING RECORD

Give All Information Completely
Make Required Affidavit
Mail or Deliver Report to:
Conservation Division
State Corporation Commission
800 Bitting Building
Wichita, Kansas

NORTH

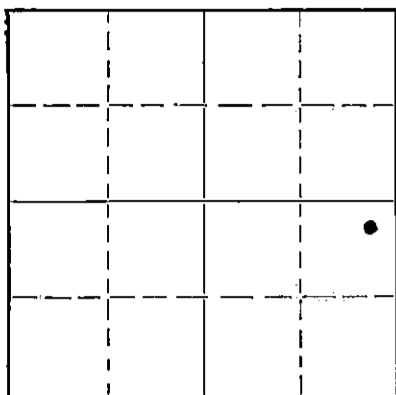

Locate well correctly on above
Section Plat

Stafford County. Sec. 35 Twp. 22 Rge. 12 (E) W (W)
Location as "NE/CNW $\frac{1}{4}$ SW $\frac{1}{4}$ " or footage from lines N.E. $\frac{1}{4}$ NE - SE
Lease Owner Thunderbird Drilling Inc.
Lease Name Rogers Well No. 1
Office Address 1311 Union National Bank Bldg. Wichita, Kans.
Character of Well (completed as Oil, Gas or Dry Hole) Dry Hole
Date well completed Sept 28 19 55
Application for plugging filed Sept 18 19 55
Application for plugging approved Sept 18 19 55
Plugging commenced Sept 19 19 55
Plugging completed Sept 27 19 55
Reason for abandonment of well or producing formation Zone produced 99% water.
If a producing well is abandoned, date of last production _____ 19____
Was permission obtained from the Conservation Division or its agents before plugging was commenced? Yes

Name of Conservation Agent who supervised plugging of this well Mr. M. A. Rives
Producing formation Arb. Depth to top 3611 Bottom _____ Total Depth of Well 3705 Feet
Show depth and thickness of all water, oil and gas formations.

OIL, GAS OR WATER RECORDS

CASING RECORD

Formation	Content	From	To	Size	Put In	Pulled Out
				8 5/8"	210'	None
				5 1/2"	3704'	1627'

Describe in detail the manner in which the well was plugged, indicating where the mud fluid was placed and the method or methods used in introducing it into the hole. If cement or other plugs were used, state the character of same and depth placed, from _____ feet to _____ feet for each plug set.

Surface to 35' plugged with cement. 35' to 185' with mud 185' to 200' with cement
200' to 3565' with mud 3565' to 3600' with cement 3600' to 3674' with chat 3674'
to 3705' with cement. All cement plugs run in hole with bailer.

(If additional description is necessary, use BACK of this sheet)

Correspondence regarding this well should be addressed to Thunderbird Drilling Inc., 1311 Union Nat. Bank
Address Bldg., Wichita, Kans.

STATE OF Kansas, COUNTY OF Sedgwick, ss.
Charles W. Aikins, Jr. (employee of owner) or (owner or operator) of the above-described well,
being first duly sworn on oath, says: That I have knowledge of the facts, statements, and matters herein contained and the log of the above-described well as filed and that the same are true and correct. So help me God.
(Signature) Charles W. Aikins, Jr., Pres.
1311 Union Nat'l Bank Bldg.
(Address)

SUBSCRIBED AND SWORN to before me this 1st day of November, 1955.

My commission expires August 25, 1956 Leta Helm Notary Public.

22-5133-8 9-48-10M
PLUGGING
FILE SEC 35 T. 22 R. 12 W
BOOK PAGE 5 LINE 31

11-2-55
DIVISION
Wichita, Kansas