


WELL PLUGGING RECORD

Give All Information Completely  
Make Required Affidavit  
Mail or Deliver Report to:  
Conservation Division  
State Corporation Commission  
211 No. Broadway  
Wichita, Kansas

NORTH

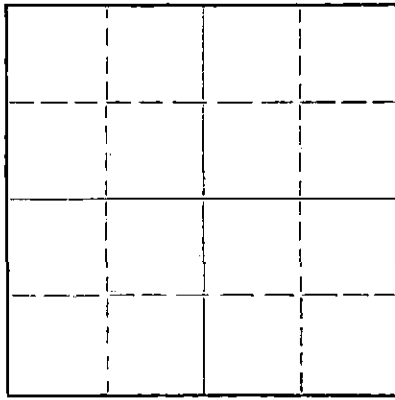

Locate well correctly on above  
Section Plat

Stafford County. Sec. 35 Twp. 22 Rge. 12 (E)-(W)  
Location as "NE/CNW/SW" or footage from lines SW SW SE  
Lease Owner E. H. Adair, L.B. Phillips, Jr. and The Holly Oil Co.  
Lease Name Rogers Well No. 2  
Office Address 1019 E. Second Street (Adair);  
Wichita, Kansas.  
Character of Well (completed as Oil, Gas or Dry Hole) Dry-hole.  
Date well completed 6-28 19 56  
Application for plugging filed 6-28 19 56  
Application for plugging approved 6-28 19 56  
Plugging commenced 6-28 19 56  
Plugging completed 6-29 19 56  
Reason for abandonment of well or producing formation Dry-hole.

If a producing well is abandoned, date of last production was not. 19       
Was permission obtained from the Conservation Division or its agents before plugging was commenced? Yes.

Name of Conservation Agent who supervised plugging of this well R. M. Brundage, Box 283, Hoisington, Kansas.  
Producing formation      Depth to top      Bottom      Total Depth of Well 3680 Feet  
Show depth and thickness of all water, oil and gas formations.

OIL, GAS OR WATER RECORDS

CASING RECORD

FORMATION	CONTENT	FROM	TO	SIZE	PUT IN	PULLED OUT
(Copy of drillers' log attached hereto).						

Describe in detail the manner in which the well was plugged, indicating where the mud fluid was placed and the method or methods used in introducing it into the hole. If cement or other plugs were used, state the character of same and depth placed, from      feet to      feet for each plug set.

First plug at 210 feet with 20 sacks of cement;  
second plug at 35 feet with 10 sacks of cement.  
Filled to surface with dirt and sand.

(If additional description is necessary, use BACK of this sheet)

Name of Plugging Contractor Murfin Drilling Company  
Address 507 Union National Bldg., Wichita 2, Kansas.

STATE OF KANSAS, COUNTY OF SEDGWICK, ss.  
Sherrill Compton (employee of owner) or (owner or operator) of the above-described well, being first duly sworn on oath, says: That I have knowledge of the facts, statements, and matters herein contained and the log of the above-described well as filed and that the same are true and correct. So help me God.

(Signature) Sherrill Compton  
Sherrill Compton

1019 E. Second St.  
Wichita, Kansas. (Address)

SUBSCRIBED AND SWORN TO before me this 11th day of July, 1956.

My commission expires September 15, 1957.

L. Hill Notary Public.

PLUGGING  
FILE SEC. 35 T. 22 R. 12W  
BOOK PAGE 76 LINE 9

7-12-56

E. H. Adair Oil Company  
1019 East Second St.  
Wichita 7, Kansas.

E. H. Adair, L. E. Phillips, Jr., and  
The Holly Oil Company

No. 2. Rogers  
SW SW SE of  
Sec. 35-22S.-12W.  
Stafford County, Kansas.

Elev.: 1830 K.B.

Comm. @ 6-18-56

Comp.: 6-28-56

Contractor:

Murfin Drilling Co.  
8-5/8 @ 240 ft. w/175 sx.

Pro. D. & A.

Figures indicate bottoms of Formations

Shale	to	575	Lime	to	3363
Lime & shale		600	Shale		3364
Shale		890	Lime		3426
Anhydrite		920	Shale		3428
Shale		1100	Oolitic lime		3436
Shale		1515	Lime		3445
Shale & lime		1865	Shale		3448
Lime		1995	Lime		3526
Lime & shale		3130	Black shale		3527
Heebner		3136	Lime		3530
Lime & shale		3208	Shale		3535
Shale		3268	Lime		3550
Lime		3280	Black shale		3551
Shale		3294	Lime		3555
Lime		3314	Shale		3563=
Shale		3319	Lime		3568
Lime		3338	Shale		3597
Shale		3341	Chert		3601
Lime		3348	Cherty shale		3640
Shale		3350	Dolomite		3680
			T.D.		3680

DST #1. 3600-32. Open 25 minutes. Shut in 20 minutes. Weak blow for 7 minutes. Recovered 25 feet of mud. BHP = 250 lbs.

DST #2. 3598-3648. Open 30 minutes. Shut in 20 minutes.. Weak blow for 9 minutes. Recovered 25 feet of mud. BHP = 400 lbs.

Geological Tops

Heebner	3130 (-1300)
Brown Lime	3268 (-1438)
Lansing K.C.	3294 (-1464)
Base K.C.	3545 (-1750)
Conglomerate	3568 (-1738)
Viola	3597 (-1767)
Erosional Arbuckle	3606 (-1776)
Solid Arbuckle	3640 (-1810)

Certified correct:

*Sherrill Compton*  
Sherrill Compton Geologist.

PLUGGING			
FILE	SEC	T	R
	35	22	12W
BOOK	PAGE	LINE	
	76	9	

RECEIVED  
COMMISSION  
JUL 19 1956  
DIVISION  
WICHITA, KANSAS