


STATE OF KANSAS
STATE CORPORATION COMMISSION

Give All Information Completely
Make Required Affidavit
Mail or Deliver Report to:
Conservation Division
State Corporation Commission
800 Bittling Building
Wichita, Kansas

WELL PLUGGING RECORD

NORTH

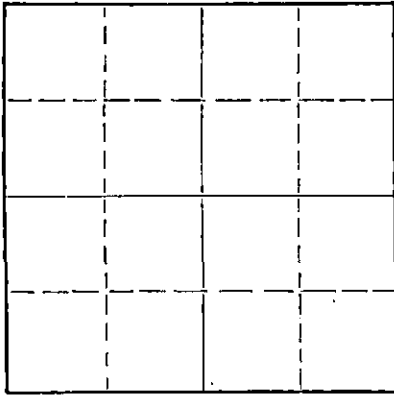

Locate well correctly on above
Section Plat

Stafford County. Sec. 35 Twp. 22S Rge. 12W (E)-(W)
Location as "NE/CNW/SW" or footage from lines SW SE NE
Lease Owner E.H. Adair Oil Company & Holly Oil Company.
Lease Name Rogers (Anna) Well No. 1
Office Address Adair - 1017 East Second Street, Wichita 7, Kansas.
Character of Well (completed as Oil, Gas or Dry Hole) Dry Hole
Date well completed 9-28 19 55
Application for plugging filed 10-3 19 55
Application for plugging approved 10-3 19 55
Plugging commenced 10-3 19 55
Plugging completed 10-3 19 55
Reason for abandonment of well or producing formation Dry Hole

If a producing well is abandoned, date of last production --- 19
Was permission obtained from the Conservation Division or its agents before plugging was commenced? Yes.

Name of Conservation Agent who supervised plugging of this well Warren H. Horner, Box 207, Great Bend, Kansas.
Producing formation --- Depth to top --- Bottom --- Total Depth of Well --- Feet
Show depth and thickness of all water, oil and gas formations.

OIL, GAS OR WATER RECORDS

CASING RECORD

FORMATION	CONTENT	FROM	TO	SIZE	PUT IN	PULLED OUT
(Copy of Driller's log attached hereto)						

Describe in detail the manner in which the well was plugged, indicating where the mud fluid was placed and the method or methods used in introducing it into the hole. If cement or other plugs were used, state the character of same and depth placed, from --- feet to --- feet for each plug set.

Bottom plug at 225 feet, 1/3 sax hulls, 20 sax cement.
Top plug at 35 feet, 1/3 sax hulls, 10 sax cement. Filled to surface.


10-13-55

(If additional description is necessary, use BACK of this sheet)
Name of Plugging Contractor Plugged by drilling Contractor, Ben F. Brack Oil Company
Address 309-10 Brown Bldg. Wichita 2, Kansas.

STATE OF KANSAS, COUNTY OF SEDGWICK, ss.
E. H. ADAIR (employee of owner) or (owner or operator) of the above-described well, being first duly sworn on oath, says: That I have knowledge of the facts, statements, and matters herein contained and the log of the above-described well as filed and that the same are true and correct. So help me God.
(Signature) E. H. Adair.
(Address)

SUBSCRIBED AND SWORN TO before me this 11th day of October, 19 55.

My commission expires 9-15-57. L. Hill Notary Public.

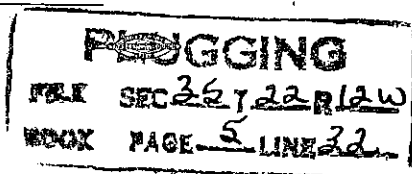

BEN F. BRACK OIL COMPANY, INC.
309-10 BROWN BUILDING
WICHITA 2, KANSAS

ANNA ROGERS #1

SW SE NE

Sec. 35-22S-12W
Stafford County, Kansas
Commenced: 9-17-55
Completed: 9-28-55

TOTAL DEPTH: 3650'
ELEVATION: 1825' DF

WELL LOG

Sand, Shale, & Red Bed	0 -	233'
Red Bed		410
Red Bed & Shale		1145
Shale & Shells		1500
Lime & Shale		1580
Lime		1811
Lime & Shale		1863
Shale & Shells		2805
Shale & Lime		3005
Lime & Shale		3263
Shale & Lime		2302
Lime		3350
Lime & Shale		3442
Lime		3604
Shale		3627
Lime		3650 T.D.

The above depths denote bottom of formations.

CASING

8 5/8" 233

To the best of my knowledge, the above is a true and correct statement of the depths and formations and where found.

BEN F. BRACK OIL COMPANY, INC.

By Bernard S. Grant

WITNESSED:

Gertrude Crist

September 30, 1955.

PLUGGING
FILE SEC 35-22S-12W
BOOK PAGE 5 LINE 32