


STATE OF KANSAS
STATE CORPORATION COMMISSION

Give All Information Completely
Make Required Affidavit
Mail Or Deliver Report to:
Conservation Division
State Corporation Commission
212 No. Market
Wichita, Kansas

WELL PLUGGING RECORD

NORTH

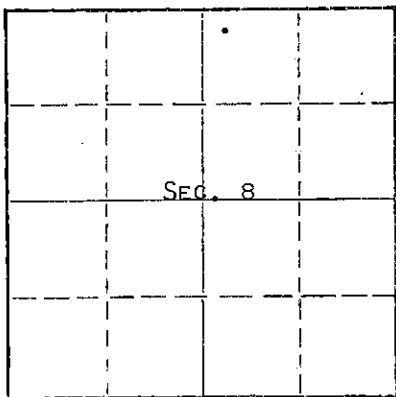

Locate well correctly on above
Section Plat

STAFFORD County, Sec. 8 Twp. 22s Rge. 13 (E)(W)
Location as "NE/CNW/SW" or footage from lines NW NW NE
Lease Owner PETROLEUM, INC.,
Lease Name SCHMIDT 'U' (WASHDOWN) Well No. 1
Office Address R.R. #2, GREAT BEND, KANSAS
Character of Well (completed as Oil, Gas or Dry Hole) DRY HOLE
Date well completed JUNE 27 19 69
Application for plugging filed JUNE 27 19 69
Application for plugging approved JUNE 27 19 69
Plugging commenced JUNE 27 19 69
Plugging completed JUNE 27 19 69
Reason for abandonment of well or producing formation NO PRODUCIBLE ZONE

If a producing well is abandoned, date of last production NONE 19
Was permission obtained from the Conservation Division or its agents before plugging was commenced? YES

Name of Conservation Agent who supervised plugging of this well
Producing formation Depth to top Bottom Total Depth of Well 3818' Feet
Show depth and thickness of all water, oil and gas formations.

OIL, GAS OR WATER RECORDS

CASING RECORD

FORMATION	CONTENT	FROM	TO	SIZE	PUT IN	PULLED OUT
				8-5/8"	280	NONE

Describe in detail the manner in which the well was plugged, indicating where the mud fluid was placed and the method or methods used in introducing it into the hole. If cement or other plugs were used, state the character of same and depth placed, from feet to feet for each plug set.

HEAVY MUD TO 450' FOLLOWED WITH 50 SACKS CEMENT. HEAVY MUD TO 240', FOLLOWED WITH 25 SACKS CEMENT. HEAVY MUD TO 40', FOLLOWED WITH 10 SACKS CEMENT TO BASE OF WELL CELLAR.

RECEIVED
STATE CORPORATION COMMISSION
JUL 25 1969
CONSERVATION DIVISION
Wichita, Kansas

(If additional description is necessary, use BACK of this sheet)
Name of Plugging Contractor GARVEY DRILLING COMPANY
Address R.R. #2, GREAT BEND, KANSAS

STATE OF KANSAS, COUNTY OF BARTON, ss.
MONTE CHADD (employee of owner) or (owner or operator) of the above-described well, being first duly sworn on oath, says: That I have knowledge of the facts, statements, and matters herein contained and the log of the above-described well as filed and that the same are true and correct. So help me God. MONTE CHADD, DIST. PROD. SUPT.

(Signature) *Monte Chadd*
R.R. #2, GREAT BEND, KANSAS
(Address)

Subscribed and sworn to before me this 24 day of JULY, 19 69
Richard H. Dumler
Notary Public.

My commission expires 8; 1973




Company - STERLING DRILLING COMPANY et al
 Farm - Schmidt No. 1

SEC. 8 T. 22S R. 13W
 NW NW NE

Total Depth. 3815'
 Comm. 6-24-48 Comp. 7-10-48
 Shot or Treated.
 Contractor. Sterling Drilling Co.
 Issued. 8-14-48

County. Stafford
 KANSAS

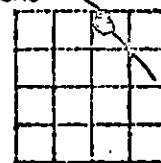

CASING: 280' 8 5/8" cem. w/250 sacks

Elevation. _____

Production. Dry

Figures Indicate Bottom of Formations.

sand & clay	240
shale & shells	280
red bed	360
sand	410
red bed	760
anhydrite	790
red bed	930
red bed & shale	1210
shale & shells	1510
shale	1590
shale & lime	1670
lime	2040
lime & shale	2870
lime	2910
lime & shale	2985
lime	3080
lime broken	3088
shale	3123
lime	3130
shale & lime	3335
shale	3398
lime	3650
lime & shale	3695
lime	3723
sand & shale	3733
shale	3768
dolomite	3782
arbuckle	3815
Total Depth	

Tops:

Heebner Shale	3248
Brown Lime	3379
Lansing (white)	3395
Cong. (Shaley)	3658
Cong. (Chert)	3674
Viola (residual chert)	3685
Simpson (weathered shale)	3728
Sandy Shale	3750-59
Arbuckle	3782

Took Drill Stem Test in arbuckle.
 Test recovered 150' of black sulphur
 water in 30 minutes with 1200'
 Bottom Hole Pressure in 5 minutes.
 No oil shows found.

Ran Schlumberger Electric Log at
 total depth.

RECEIVED
 STATE CORPORATION COMMISSION
 MAY 13 1970
 CONSERVATION DIVISION
 Wichita, Kansas