

STATE OF KANSAS
STATE CORPORATION COMMISSION


WELL PLUGGING RECORD

Give All Information Completely
Make Required Affidavit
Mail or Deliver Report to:
Conservation Division
State Corporation Commission
800 Bitting Building
Wichita, Kansas

Stafford County, Sec. 8 Twp. 22S Rge. 13 (E) W (W)

Location as "NE/CNW/SW" or footage from lines SE SE NW
Lease Owner Vickers Petroleum Co., Inc. & Jayhawk Drilling Co., Inc.
Lease Name Garvin Well No. 1
Office Address Box 2240, Wichita, Kansas
Character of Well (completed as Oil, Gas or Dry Hole) Dry Hole
Date well completed October 3 19 52
Application for plugging filed October 3 19 52
Application for plugging approved October 3 19 52
Plugging commenced October 4 19 52
Plugging completed October 4 19 52
Reason for abandonment of well or producing formation Dry

NORTH

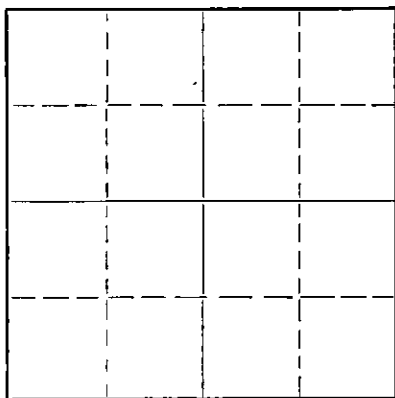

Locate well correctly on above
Section Plat

If a producing well is abandoned, date of last production 19
Was permission obtained from the Conservation Division or its agents before plugging was commenced? yes

Name of Conservation Agent who supervised plugging of this well Mr. M. A. Rives, Pratt, Kansas
Producing formation Depth to top Bottom Total Depth of Well 3835 Feet
Show depth and thickness of all water, oil and gas formations.

OIL, GAS OR WATER RECORDS

CASING RECORD

FORMATION	CONTENT	FROM	TO	SIZE	PUT IN	PULLED OUT
				8 5/8"	325'	None

Describe in detail the manner in which the well was plugged, indicating where the mud fluid was placed and the method or methods used in introducing it into the hole. If cement or other plugs were used, state the character of same and depth placed, from feet to feet for each plug set.

Filled hole to 300' and set plug w/ 20 sx cement
Filled to 35' and set plug w/ 10 sx cement

RECEIVED
STATE CORPORATION COMMISSION

OCT 11 1952 10-11-52

CONSERVATION DIVISION
Wichita, Kansas

(If additional description is necessary, use BACK of this sheet)

Name of Plugging Contractor Jayhawk Drilling Co., Inc.
Address Box 2240, Wichita, Kansas


STATE OF Kansas, COUNTY OF Sedgwick, ss.
John M. Little (employee of owner) or (owner or operator) of the above-described well, being first duly sworn on oath, says: That I have knowledge of the facts, statements, and matters herein contained and the log of the above-described well as filed and that the same are true and correct. So help me God.

(Signature) *John M. Little*
Box 2240, Wichita, Kansas (Address)

SUBSCRIBED AND SWORN TO before me this 9th day of October, 19 52

My commission expires August 13, 1953

Allen P. Denton
Notary Public.

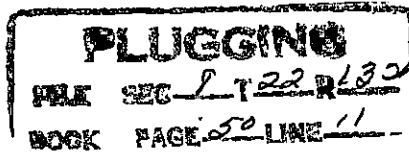

THE VICKERS PETROLEUM CO., INC.
AND
THE JAYHAWK DRILLING CO., INC.

Garvin Well #1
SE SE NW, Sec. 8-22S-13W
Stafford County, Kansas

Casing Record
8 5/8" @ 325' w/ 250' sx

Commenced: September 22, 1952
Completed: October 3, 1952

Elevation: 1911 R.B.
D & A.

LOG

Sand & Clay	0- 295
Red Beds	295- 420
Red Beds & Sand	420- 800
Anhydrite	800- 825
Red Beds, Shale & Shells	825- 950
Shale, Shells & Salt	950-1415
Lime & Shale	1415-1705
Broken Lime	1705-1800
Lime & Sand	1800-1990
Broken Lime	1990-2005
Sand & Lime	2005-2040
Lime	2040-2090
Lime & Shale	2090-3035
Lime	3035-3165
Lime & Shale	3165-3280
Black Shale	3280-3283
Lime & Shale	3283-3299
Lime	3299-3319
Shale	3319-3409
Lime	3409-3414
Shale & Lime	3414-3420
Lime	3420-3655
Shale & Lime	3655-3673
Shale & Chert	3673-3711
Chert White	3711-3754
Shale & Sand	3754-3814
Dolomite	3814-3835 T.D.

SAMPLE TOPS

Heebner	3280
Toronto	3299
Brown Lime	3409
Lansing	3420
Base Kans. City	3655
Conglomerate Shale	3673
Viola Chert	3711
Simpson Shale	3754
Arbuckle	3814

I hereby certify that this Log is true and correct to the best of my knowledge and belief.

THE CORPORATION COMMISSION

OCT 11 1952

THE VICKERS PETROLEUM CO., INC.

CONSERVATION DIVISION
Wichita, Kansas

BY *[Signature]*

Sworn and subscribed to before me this 9th day of October, 1952.

Allen J. Denton
Notary Public

My Commission expires August 13, 1953.

