


WELL PLUGGING RECORD

Give All Information Completely  
Make Required Affidavit  
Mail or Deliver Report to:  
Conservation Division  
State Corporation Commission  
808 Biting Building  
Wichita, Kansas

NORTH

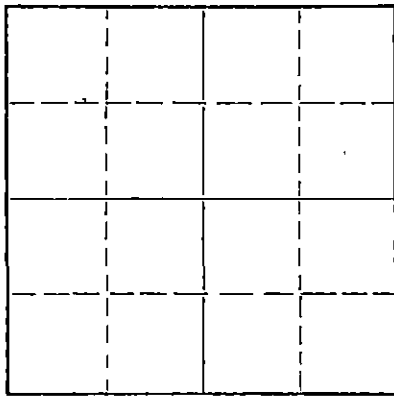

Locate well correctly on above  
Section Plat

Stafford County. Sec. 3 Twp. 22 Rge. (E) 14 (W)  
Location as "NE/CNWxSWx" or footage from lines NW NW SE  
Lease Owner Petroleum, Inc.  
Lease Name GARVIN 'A' Well No. 1  
Office Address 311 East Third  
Character of Well (completed as Oil, Gas or Dry Hole) Dry Hole  
Date well completed October 1 19 55  
Application for plugging filed October 1 19 55  
Application for plugging approved October 1 19 55  
Plugging commenced October 1 19 55  
Plugging completed October 1 19 55  
Reason for abandonment of well or producing formation \_\_\_\_\_

Dry Hole  
If a producing well is abandoned, date of last production \_\_\_\_\_ 19 \_\_\_\_  
Was permission obtained from the Conservation Division or its agents before plugging was commenced? yes

Name of Conservation Agent who supervised plugging of this well Mr. W. H. Horner, Great Bend, Kansas  
Producing formation \_\_\_\_\_ Depth to top \_\_\_\_\_ Bottom \_\_\_\_\_ Total Depth of Well 3818 Feet  
Show depth and thickness of all water, oil and gas formations.

OIL, GAS OR WATER RECORDS

CASING RECORD

FORMATION	CONTENT	FROM	TO	SIZE	PUT IN	PULLED OUT
				8-5/8"	226'	None

Describe in detail the manner in which the well was plugged, indicating where the mud fluid was placed and the method or methods used in introducing it into the hole. If cement or other plugs were used, state the character of same and depth placed, from \_\_\_\_\_ feet to \_\_\_\_\_ feet for each plug set.

Mudded up to 225' and set wooden plug. Placed

1/3 sack hulls on top of plug and displaced 20

sacks of cement through drill pipe onto hulls.

Mudded up to 35' and set second wooden plug; placed

1/3 sack of hulls on plug and filled hole to base

of well cellar with 10 sacks cement.

(If additional description is necessary, use BACK of this sheet)

Name of Plugging Contractor Garvey Drilling Company  
Address R. R. #2 - Great Bend, Kansas

STATE OF KANSAS, COUNTY OF SEDGWICK, ss.  
Karl E. Becker (employee of owner) or (~~owner or operator~~) of the above-described well, being first duly sworn on oath, says: That I have knowledge of the facts, statements, and matters herein contained and the log of the above-described well as filed and that the same are true and correct. So help me God.

(Signature) Karl E. Becker  
311 East Third, Wichita, Kansas (Address)

SUBSCRIBED AND SWORN TO before me this 1st day of October, 19 55

My commission expires September 2, 1959

Frances Sloan  
Frances Sloan, Notary Public Notary Public.  
My commission expires Sept. 2, 1959

**PLUGGING**  
FILE SEC 3 T 22 R 14 W  
BOOK PAGE 3 LINE 28

10-14-55

# WELL LOG

COMPANY **Petroleum, Inc.**

SEC. **3** T. **22** R. **14W**

FARM **OWEN 'A'** NO. **1**


LOC. **NW 1/4 Sec 3  
2310' F&L  
2310' F&L**

TOTAL DEPTH **3810'**

COUNTY **Stafford**

COMM. **September 20, 1955** COMP. **September 30, 1955**

CONTRACTOR **Conroy Drilling Company**

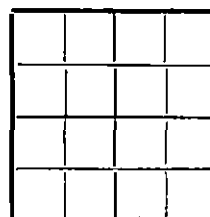

CASING **8-5/8" O 226' w/200 s&x**

ELEVATION **1941' BP  
1943' BS**

PRODUCTION **O & A**

FIGURES INDICATE BOTTOM OF FORMATIONS

30	Surface Sand & Clay
145	Sand
226	Blue Shale
335	Shale & Sand
670	Red Red & Shale
835	Sand
840	Anhydrite
1135	Shale & Shells
1225	Shale & Lime
1300	Shale & Shells
1400	Salt & Shale
2200	Lime & Shale
2360	Shale
3175	Lime & Shale
3235	Lime, Shale & Sand
3345	Lime & Shale
3405	Shale
3425	Shale & Lime
3682	Lime
3710	Lime & Conglomerate
3733	Chert
3770	Cherty Lime
3780	Shale & Lime
3793	Simpson
3810	Arbuckle

Shale Tops

Seebart:	3301' (-1351)
Brown Lime:	3424' (-1481)
Luntings:	3634' (-1681)
Conglomerate:	3700' (-1757)
Viola:	3718' (-1775)
Simpson:	3763' (-1820)
Arbuckle:	3793' (-1850)

**S.P.S. 3810'**

State of KANSAS

County of SENECA

**PLUGGING**  
 FILE SEC. 3 T. 22 R. 14W  
 BOOK PAGE 5 LINE 28

I, Karl E. Becker

of Petroleum, Inc.

upon oath state that the above and foregoing is a true and correct copy of the log of the OWEN 'A' #1 well

Subscribed and sworn to before me this 7th day of October 19 55

My Commission Expires: September 2, 1959

Karl E. Becker  
 \_\_\_\_\_  
 Frances Sloan  
 Notary Public  
 My commission expires 9-2-59