


STATE OF KANSAS
STATE CORPORATION COMMISSION

WELL PLUGGING RECORD

Give All Information Completely
Make Required Affidavit
Mail or Deliver Report to
Conservation Division
State Corporation Comm.
245 North Water
Wichita, KS 67202

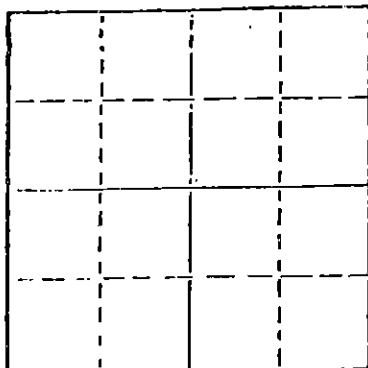

Locate well correctly on above
Section Plot

Stafford County. Sec. 3 Twp. 22S Rge. 14 X/W
Location as "NE/CNW $\frac{1}{2}$ SW $\frac{1}{4}$ " or footage from lines
NE NW SE

Lease Owner Black Gold Exploration Ltd.
Lease Name Hickman Well No. Smallwood #1
Office Address 7555 E. Hampden Ave., Suite 413, Denver, Colo.
Character of Well (Completed as Oil, Gas or Dry Hole) Dry Hole

Date Well completed September 7 19 80
Application for plugging filed September 7 19 80
Application for plugging approved September 7 19 80
Plugging commenced September 7 19 80
Plugging completed September 7 19 80
Reason for abandonment of well or producing formation

Dry Hole

If a producing well is abandoned, date of last production 19 80

Was permission obtained from the Conservation Division or its agents before plugging was commenced? Yes

Name of Conservation Agent who supervised plugging of this well Bill Owens
Producing formation Depth to top Bottom Total Depth of Well 3554'
Show depth and thickness of all water, oil and gas formations.

OIL, GAS OR WATER RECORDS

CASING RECORD

FORMATION	CONTENT	FROM	TO	SIZE	PUT IN	PULLED OUT
				8 5/8"	249'	

Describe in detail the manner in which the well was plugged, indicating where the mud fluid was placed and the method or methods used in introducing it into the hold. If cement or other plugs were used, state the character of same and depth placed, from feet to feet for each plug set.

1st plug 540' w/50 Sacks
2nd plug 240' w/40 Sacks
3rd plug 40' w/10 Sacks
5 Sacks in rat hole

RECEIVED
STATE CORPORATION COMMISSION
SEP 12 1980
CONSERVATION DIVISION
Wichita, Kansas

(If additional description is necessary, use BACK of this sheet)


Name of Plugging Contractor RoCo Drilling, Inc.

STATE OF Kansas COUNTY OF Barton, ss.
Richard L. Miller (employee of owner) or (owner or operator)
of the above-described well, being first duly sworn on oath, says: That I have knowledge of the facts, statements, and matters herein contained and the log of the above-described well as filed and that the same are true and correct. So help me God.

(Signature) Richard L. Miller
1819 - 11th St., Great Bend, Kansas 67530
(Address)

SUBSCRIBED AND SWORN TO before me this 11th day of Sept., 19 80

Mary C. Hooks
Notary Public.

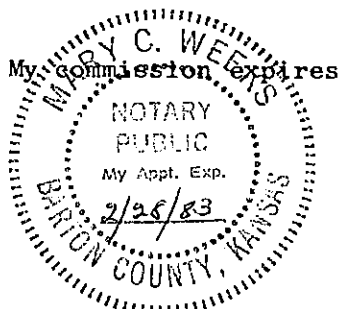

Feb. 28, 1983

RoCo DRILLING, INC.

GREAT BEND, KANSAS 67530

P. O. BOX 11
1819 ELEVENTH STREET
TELEPHONE (316) 792-1383

DRILLERS WELL LOG

Hickman-Smallwood #1
NE NW SE
Section 3-22S-14W
Stafford County, Kansas

Operator: Black Gold Exploration Ltd.
7555 E. Hampden Ave.
Suite 413
Denver, Colo. 80231

Date Commenced: September 2, 1980
Date Completed: September 7, 1980

Total Depth: 3554'
D & A

Casing: 8 5/8" @ 249' w/200 Sks

<u>DEPTH</u>		<u>FORMATION</u>	<u>ELECTRIC LOG TOPS</u>
<u>FROM</u>	<u>TO</u>		
0	200	Surface Soil & Sand	No Electric Log Run
200	840	Sand, Red Beds & Shells	
840	867	ANHYDRITE	
867	1765	Shale & Shells	
1765	3554	Lime & Shale	
	3554	Rotary Total Depth	

I, Richard L. Miller, certify this is a correct copy of the Driller's Log from the well drilled at the above location, to the best of my knowledge and belief.

Signed: Richard L. Miller
Richard L. Miller

RECEIVED
STATE CORPORATION COMMISSION
SEP 12 1980
CONSERVATION DIVISION
Wichita, Kansas