

STATE OF KANSAS  
STATE CORPORATION COMMISSION


Form CP-4

WELL PLUGGING RECORD

Give All Information Completely  
Make Required Affidavit  
Mail or Deliver Report to:  
Conservation Division  
State Corporation Commission  
212 No. Market  
Wichita, Kansas

Stafford County, Sec. 3 Twp. 22S Rge. (E) 14 (W)

Location as "NE/CNW/SW" or footage from lines SE SE NE  
Lease Owner Petroleum, Inc.  
Lease Name Curtis C #1 (Smallwood Lan-KC Unit #1-1) Well No. \_\_\_\_\_  
Office Address 352 North Broadway, Wichita, Kansas  
Character of Well (completed as Oil, Gas or Dry Hole) oil  
Date well completed December 22 1954  
Application for plugging filed February 24 1966  
Application for plugging approved February 25 1966  
Plugging commenced March 2 1966  
Plugging completed March 8 1966  
Reason for abandonment of well or producing formation depleted

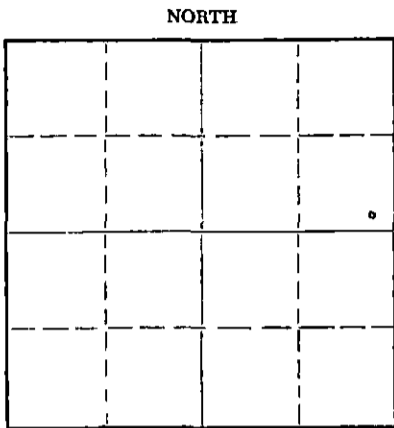

Locate well correctly on above  
Section Plat

If a producing well is abandoned, date of last production \_\_\_\_\_ 19\_\_\_\_  
Was permission obtained from the Conservation Division or its agents before plugging was commenced? yes

Name of Conservation Agent who supervised plugging of this well Archie Elving  
Producing formation \_\_\_\_\_ Depth to top \_\_\_\_\_ Bottom \_\_\_\_\_ Total Depth of Well 3825 Feet  
Show depth and thickness of all water, oil and gas formations.

OIL, GAS OR WATER RECORDS

CASING RECORD

FORMATION	CONTENT	FROM	TO	SIZE	PUT IN	PULLED OUT
		0	220'	8 5/8"	220'	none
		0	3685'	4 1/2"	3685'	3159.80

Describe in detail the manner in which the well was plugged, indicating where the mud fluid was placed and the method or methods used in introducing it into the hole. If cement or other plugs were used, state the character of same and depth placed, from \_\_\_\_\_ feet to \_\_\_\_\_ feet for each plug set.

Pushed plug to 3550', set 10' rock bridge and dumped 3 sacks of cement at 3540'.  
Pushed plug to 200', set 10' rock bridge and dumped 8 sacks of cement at 190'. Bailed hole down and dumped 17 sacks of cement. Filled hole with mud to 40', set 10' rock bridge and capped hole with 10 sacks of cement.

STATE CORPORATION COMMISSION

MAR 28 1966

CONSERVATION DIVISION  
Wichita, Kansas

(If additional description is necessary, use BACK of this sheet)  
Name of Plugging Contractor Pipe Pullers, Inc.  
Address Box 486, Ellinwood, Kansas

STATE OF Kansas, COUNTY OF Barton, ss.  
Dean Wells (employee of owner) or (~~owner or operator~~) of the above-described well, being first duly sworn on oath, says: That I have knowledge of the facts, statements, and matters herein contained and the log of the above-described well as filed and that the same are true and correct. So help me God.

(Signature) Dean Wells

Ellinwood, Kansas  
(Address)

SUBSCRIBED AND SWORN TO before me this 15th day of March, 1966

[Signature]  
Notary Public.

My commission expires July 7, 1968

15-185-13163-0000

8860P


WELL LOG BUREAU—KANSAS GEOLOGICAL SOCIETY  
508 East Murdock, Wichita, Kansas

Company- PETROLEUM, INC.  
Farm- Curtis "C" No. 1  
*Smallwood L-KC #1-1*

SEC. 3 T. 22 R. 11W  
SE SW NE

Total Depth. 3825  
Comm. 12-12-54 Comp. 12-22-54  
Shot or Treated.  
Contractor. Garvey Drlg. Co.  
Issued. 3-5-55

County Stafford  
KANSAS

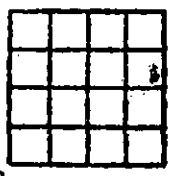

CASING:  
8 5/8" 221' com./w 175 sx  
4 1/2" 3685' com. w/50 sx

Elevation. 1941 RB

Production. 368 Bbls. oil

Figures Indicate Bottom of Formations.

clay, sand & gravel	140
sand	195
shale	221
shale & shells	275
sand	360
redbed	835
Anhydrite	860
shale & shells	1685
lime & shale	3430
lime	3667
lime & shale	3737
chert & lime	3767
shale	3997
dolomite	3825
Total depth	

Tops:	
Heebner	3306
Toronto	3329
Douglas	3345
Brown lime	3430
Lansing	3440
B. Kansas City	3667
Conglomerate	3706
Vipla	3736
Simpson	3754
Arbuckle	3797

RECEIVED  
STATE CORPORATION COMMISSION  
MAR 28 1966  
CONSERVATION DIV.  
Wichita, Kansas