


Give All Information Completely
Make Required Affidavit
Mail or Deliver Report to:
Conservation Division
State Corporation Commission
800 Biting Building
Wichita, Kansas

WELL PLUGGING RECORD

NORTH

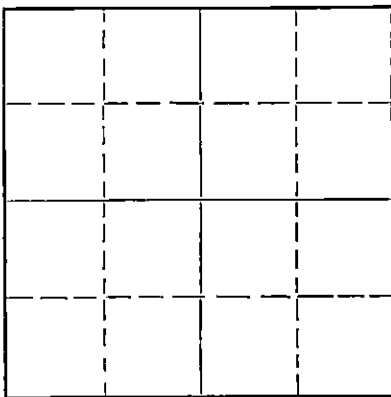

Locate well correctly on above
Section Plat

Stafford County. Sec. 3 Twp. 22 Rge. 14 (E) W (W)
Location as "NE/CNW/SW" or footage from lines NW NW NE
Lease Owner Trans Era Petroleum, Inc.
Lease Name Adams Well No. 1
Office Address Russell, Kansas
Character of Well (completed as Oil, Gas or Dry Hole) Dry
Date well completed 7/31/53 19
Application for plugging filed 7/30/53 19
Application for plugging approved 7/30/53 19
Plugging commenced 7/31/53 19
Plugging completed 7/31/53 19
Reason for abandonment of well or producing formation Dry Hole

If a producing well is abandoned, date of last production 19
Was permission obtained from the Conservation Division or its agents before plugging was commenced? Yes

Name of Conservation Agent who supervised plugging of this well M. A. Rives
Producing formation _____ Depth to top _____ Bottom _____ Total Depth of Well 3835 Feet
Show depth and thickness of all water, oil and gas formations.

OIL, GAS OR WATER RECORDS

CASING RECORD

FORMATION	CONTENT	FROM	TO	SIZE	PUT IN	PULLED OUT
				8 5/8"	263'	None

Describe in detail the manner in which the well was plugged, indicating where the mud fluid was placed and the method or methods used in introducing it into the hole. If cement or other plugs were used, state the character of same and depth placed, from _____ feet to _____ feet for each plug set.

PLUGGING RECORD

Layed down drill pipe, plugged hole. Set bottom plug at 240' with 1/2 sack of hulls & 20 sacks of cement. Top plug was set at 40' with 20 sacks of cement.

(If additional description is necessary, use BACK of this sheet)

Name of Plugging Contractor _____
Address _____

STATE OF KANSAS, COUNTY OF RUSSELL, ss.
H. R. Michaelis (employee of owner) or (owner or operator) of the above-described well, being first duly sworn on oath, says: That I have knowledge of the facts, statements, and matters herein contained and the log of the above-described well as filed and that the same are true and correct. So help me God.


(Signature) H. R. Michaelis
Russell, Kansas
(Address)

SUBSCRIBED AND SWORN to before me this 7th day of August, 19 53

My commission expires 1-30-57

24-7958-S 3-53-20M

Margie Cooper Notary Public.

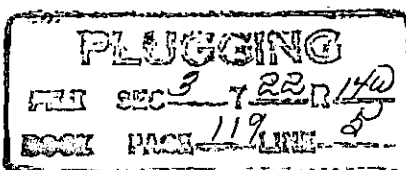

RECEIVED
STATE CORPORATION COMMISSION
AUG 11 1953
8-11-53
CONSERVATION DIVISION
Wichita, Kansas

Trans-Kra Petroleum, Inc.
Adams #1

NW NW NE 3-22-14
Stafford County, Ks.

Total Depth: 3835'
Comm. 7/18/53
Comp. 7/31/53

Casing

8 5/8" Set @ 263'

Cement

230 sacks Lehigh

Formation

Depth

Sand	149
Sand-shale	263
Red bed-sand	838
Shale	1430
Shale-lime	3463
Lime	3631
Lime-shale	3682
Shale-lime-chert	3746
Cherty lime	3772
Arbuckle	3835'

STATE OF KANSAS }
RUSSELL COUNTY } ss

I hereby certify that the above information is true and correct to
the best of my knowledge.

Cora Beth

Subscribed and sworn to before me this 7th day of August, 1953.

Margie Cooper
Notary Public

My commission expires: 1-30-57.

