

STATE OF KANSAS
STATE CORPORATION COMMISSION


Form CP-4

WELL PLUGGING RECORD

Give All Information Completely
Make Required Affidavit
Mail or Deliver Report to:
Conservation Division
State Corporation Commission
212 No. Market
Wichita, Kansas

Stafford County. Sec. 3 Twp. 22S Rge. (E) 14(W)

Location as "NE/CNW/SW" or footage from lines NE SE NE
Lease Owner Petroleum, Inc.
Lease Name Curtis C #2 (Smallwood Lan-KC Unit #1-2)
Office Address 352 North Broadway, Wichita, Kansas
Character of Well (completed as Oil, Gas or Dry Hole) oil
Date well completed October 12 1955
Application for plugging filed February 24 1966
Application for plugging approved February 25 1966
Plugging commenced February 26 1966
Plugging completed March 8 1966
Reason for abandonment of well or producing formation depleted

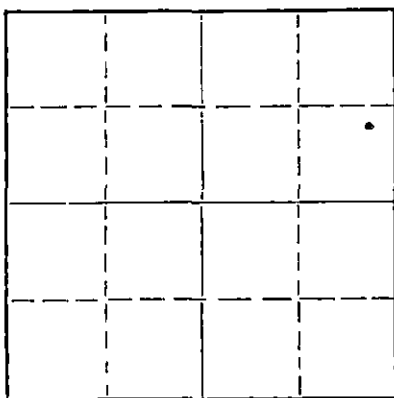

Locate well correctly on above Section Plat

If a producing well is abandoned, date of last production _____ 19____
Was permission obtained from the Conservation Division or its agents before plugging was commenced? yes

Name of Conservation Agent who supervised plugging of this well Archie Elving
Producing formation _____ Depth to top _____ Bottom _____ Total Depth of Well 3840 Feet
Show depth and thickness of all water, oil and gas formations.

OIL, GAS OR WATER RECORDS

CASING RECORD

FORMATION	CONTENT	FROM	TO	SIZE	PUT IN	PULLED OUT
		0	230'	8 5/8"	230'	none
		0	3722'	4 1/2"	3722'	2768.80

Describe in detail the manner in which the well was plugged, indicating where the mud fluid was placed and the method or methods used in introducing it into the hole. If cement or other plugs were used, state the character of same and depth placed, from _____ feet to _____ feet for each plug set.

Pushed plug to 3560'. Set 10' rock bridge. Mixed 3 sacks of cement and dumped at 3550'.
Pushed plug to 220', set 10' rock bridge and dumped 8 sacks of cement. Bailed hole down. Dumped 17 sacks of cement. Filled hole with mud to 40', set 10' rock bridge and capped hole with 10 sacks of cement.

RECEIVED
STATE CORPORATION COMMISSION
MAR 28 1966
CONSERVATION DIVISION
Wichita, Kansas

(If additional description is necessary, use BACK of this sheet)
Name of Plugging Contractor Pipe Pullers, Inc.
Address Box 486, Ellinwood, Kansas

STATE OF Kansas, COUNTY OF Barton, ss.
Dean Wells (employee of owner) or (~~owner or operator~~) of the above-described well, being first duly sworn on oath, says: That I have knowledge of the facts, statements, and matters herein contained and the log of the above-described well as filed and that the same are true and correct. So help me God.

(Signature) Dean Wells
Ellinwood, Kansas (Address)

SUBSCRIBED AND SWORN TO before me this 15th day of March, 1966

My commission expires July 7, 1968 J. J. Rader Notary Public.

WELL LOG BUREAU - KANSAS GEOLOGICAL SOCIETY
508 East Murdock, Wichita, Kansas


COPY

Company: PETROLEUM, INC.
Farm: Curtis "C" No. 2
Smallwood L-KC #1-2

SEC. 3 T. 22 R. 14W
NE SE NE
330' fr FL, 1650' fr NL

Total Depth. 3840
Comm. 10-1-55 Comp. 10-12-55
Shot or Treated.
Contractor. Garvey Drilling Co.
Issued. 12-24-55

County Stafford
KANSAS

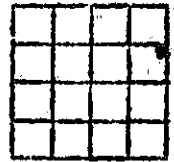

Elevation. 1942 DF

Production. 327 BOPD

CASING:

8 5/8 @ 230' w/ 200 sx cmt.
4 1/2 @ 3732' w/ 100 sx cmt.

Figures indicate Bottom of Formations.

sand & clay	215
shale	285
sand	350
red bed	560
red bed & shale	830
anhydrite	855
shale & shells	1600
lime & shale	2815
lime	2855
lime & shale	3060
lime	3140
lime & shale	3275
lime	3330
lime & shale	3429
lime	3667
lime & shale	3705
conglomerate	3730
chert & shale	3769
lime & shale	3820
A rbuckle	3840
Total Depth	

TOPS:

Heebner	3307
Toronto	3329
Douglas	3343
Brown lime	3429
Lansing	3440
Base K. C.	3665
Conglomerate	3708
Viola	3736
Simpson	3754
Arbuckle	3820

RECEIVED
STATE CORPORATION COMMISSION

MAR 28 1966
CONSERVATION DIVISION
Wichita, Kansas