

CARD MUST BE TYPED

State of Kansas
NOTICE OF INTENTION TO DRILL
(see rules on reverse side)

CORRECTION
CARD MUST BE SIGNED
10-26-84

Starting Date:11-1-84.....
month day year

API Number 15- 185-22, 108-0000

OPERATOR: License # 6170.....
Name ..Globe Exploration, Inc.....
Address P...O...Box 12.....
City/State/Zip Great Bend, KS. 67530.....
Contact Person Wayne Dobbs.....
Phone(316)..793-3282.....

* C. N. / 2 SW. SW. Sec 11. Twp 22. S, Rge 12. East
(location) West

.....990..... Ft North from Southeast Corner of Section
*4620..... Ft West from Southeast Corner of Section
(Note: Locate well on Section Plat on reverse side)

CONTRACTOR: License # ...9421.....
Name ..Boger Brothers Drilling, Inc.....
City/State Hoisington, KS. 67544.....

Nearest lease or unit boundary line330..... feet.
CountyStafford.....

Lease Name Voight "C"..... Well# ...1.....

Domestic well within 330 feet: yes no

Municipal well within one mile: yes no

Well Drilled For: Well Class: Type Equipment:
 Oil Swd Infield Mud Rotary
 Gas Inj Pool Ext. Air Rotary
 OWWO Expl Wildcat Cable

Depth to Bottom of fresh water109..... feet

Lowest usable water formationTop Permian.....

Depth to Bottom of usable water250..... feet

Surface pipe by Alternate: 1 2

Surface pipe to be set325..... feet

Conductor pipe if any requiredNA..... feet

Ground surface elevationUnknown..... feet MSL

This Authorization Expires4-12-85.....

Approved By10-12-84.....

If OWWO: old well info as follows:

Operator

Well Name

Comp Date Old Total Depth

Projected Total Depth3800..... feet

Projected Formation at TDArbuckle.....

Expected Producing Formations Lansing-KS. & Arbuckle

I certify that we will comply with K.S.A. 55-101, et seq., plus eventually plugging hole to K.C.C. specifications.

Kansas NW SW SW
4950 FEL

Date 10/25/84 Signature of Operator or Agent


Wayne Dobbs
Title

President

Must be filed with the K.C.C. five (5) days prior to commencing well
 This card void if drilling not started within six (6) months of date received by K.C.C.

Important procedures to follow :

**A Regular Section of Land
 1 Mile = 5,280 Ft.**

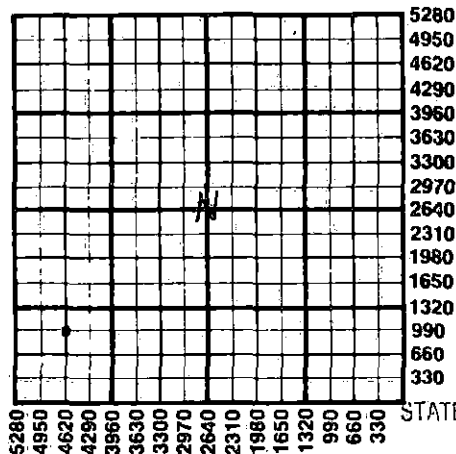

1. Notify District office before setting surface casing.
2. Set surface casing by circulating cement to the top.
3. File completion forms ACO-1 with K.C.C. within 90 days of well completion, following instructions on ACO-1, side 1, and including copies of wireline logs.
4. Notify District office 48 hours prior to old well workover or re-entry.
5. Prior to plugging, prepare a plugging plan, then obtain agreement from the appropriate district office for an approved plugging plan.
6. Submit plugging report (CP-4) to K.C.C. after plugging is completed.
7. Obtain an approved injection docket number before disposing of salt water.
8. Notify K.C.C. within 10 days when injection commences or terminates.
9. If an alternate 2 completion, cement in the production pipe from below any usable water to surface within 120 days of spud date.

RECEIVED
 STATE CORPORATION COMMISSION

State Corporation Commission of Kansas
 Conservation Division
 200 Colorado Derby Building
 Wichita, Kansas 67202
 (316) 263-3238

OCT 26 1984
 10-26-84
 CONSERVATION DIVISION
 Wichita, Kansas