

CARD MUST BE TYPED

State of Kansas
NOTICE OF INTENTION TO DRILL
(see rules on reverse side)

CORRECTION
CARD MUST BE SIGNED
10-30-84

Starting Date: ..October 29 1984
 month day year

API Number 15- 185-122, 110-0000

OPERATOR: License # ..5215
Name ..Lee Phillips Oil Company
Address ..1532 KSB Building
City/State/Zip ..Wichita, Kansas, 67202
Contact Person ..Lee E. Phillips III
Phone ..(316) 264-6392

Approximate East
NE .. NW .. SE Sec . 8 . Twp 22 . S, Rge . 14 . West
(location)

* ..2220 .. Ft North from Southeast Corner of Section
* ..1620 .. Ft West from Southeast Corner of Section
(Note: Locate well on Section Plat on reverse side)

CONTRACTOR: License # ..5122
Name ..Woodman-Iannitti
City/State ..Wichita, Kansas

Nearest lease or unit boundary line .. 330 .. feet.
County ..Stafford
Lease Name ..Estes .. Well# .. 3

Well Drilled For: Well Class: Type Equipment:
 Oil Swd Infield Mud Rotary
 Gas Inj Pool Ext. Air Rotary
 OWWO Expl. Wildcat Cable

Domestic well within 330 feet : yes no
Municipal well within one mile : yes no

If OWWO: old well info as follows:

Operator ..
Well Name ..
Comp Date .. Old Total Depth ..
Projected Total Depth ..4000 .. feet
Projected Formation at TD ..Arbuckle
Expected Producing Formations ..LKC - Simpson

Depth to Bottom of fresh water ..275 .. feet
Lowest usable water formation ..Permian
Depth to Bottom of usable water ..320 .. feet
Surface pipe by Alternate : 1 2
Surface pipe to be set ..320 .. feet
Conductor pipe if any required ..-0- .. feet
Ground surface elevation ..1952 Ground .. feet MSL
This Authorization Expires ..4-16-85

I certify that we will comply with K.S.A. 55-101, et seq., plus eventually plugging hole to K.C.C. specifications.

Date ..10-30-84 .. Signature of Operator or Agent


Lee E Phillips III

Approved By ..10-16-84
Title ..Owner
Kwas 2310 FSL
1650 FEL

Must be filed with the K.C.C. five (5) days prior to commencing well
This card void if drilling not started within six (6) months of date received by K.C.C.

Important procedures to follow :

A Regular Section of Land
1 Mile = 5,280 Ft.

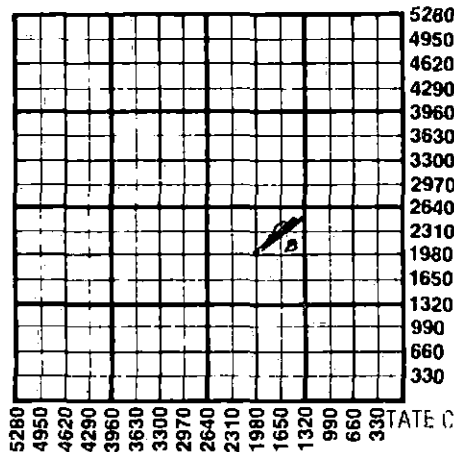

1. Notify District office before setting surface casing.
2. Set surface casing by circulating cement to the top.
3. File completion forms ACO-1 with K.C.C. within 90 days of well completion, following instructions on ACO-1, side 1, and including copies of wireline logs.
4. Notify District office 48 hours prior to old well workover or re-entry.
5. Prior to plugging, prepare a plugging plan, then obtain agreement from the appropriate district office for an approved plugging plan.
6. Submit plugging report (CP-4) to K.C.C. after plugging is completed.
7. Obtain an approved injection docket number before disposing of salt water.
8. Notify K.C.C. within 10 days when injection commences or terminates.
9. If an alternate 2 completion, cement in the production pipe from below any usable water to surface within 120 days of spud date.

RECEIVED
STATE CORPORATION COMMISSION
10-30-84

OCT 30 1984

CONSERVATION DIVISION
Wichita, Kansas

State Corporation Commission of Kansas
Conservation Division
200 Colorado Derby Building
Wichita, Kansas 67202
(316) 263-3238