

CARD MUST BE TYPED

State of Kansas
NOTICE OF INTENTION TO DRILL
(see rules on reverse side)

CARD MUST BE SIGNED

Starting Date: November.....20.....84.....
month day year

API Number 15- 185-22,129-0000
 East

OPERATOR: License # 9963.....

.... S/ 2-SW-SW Sec . 6 . Twp 22 . S, Rge . 12. West
(location)

Name GRUDE RECOVERY CORPORATION

Address 555 N. Woodlawn, Bldg. 1, Ste. 207

City/State/Zip Wichita, KS 67208

Contact Person Vern Brungardt

Phone 681-3601

330'..... Ft North from Southeast Corner of Section

4220'..... Ft West from Southeast Corner of Section

(Note: Locate well on Section Plat on reverse side)

CONTRACTOR: License # Unknown.....

Name

City/State

Nearest lease or unit boundary line 330'..... feet.

County Stafford.....

Lease Name Krankenber..... Well# 1.....

Domestic well within 330 feet : yes no

Municipal well within one mile : yes no

Well Drilled For: Well Class: Type Equipment:

- Oil Swd Infield Mud Rotary
- Gas Inj Pool Ext. Air Rotary
- OWWO Expl Wildcat Cable

If OWWO: old well info as follows:

Operator

Well Name

Comp Date Old Total Depth

Projected Total Depth 3750..... feet

Projected Formation at TD Arbuckle.....

Expected Producing Formations Arbuckle.....

Depth to Bottom of fresh water 110 *MHC*..... feet

Lowest usable water formation Top Permian.....

Depth to Bottom of usable water 250..... feet

Surface pipe by Alternate : 1 2

Surface pipe to be set 250..... feet

Conductor pipe if any required

Ground surface elevation

This Authorization Expires 5-15-85.....

Approved By 11-15-84 *R*.....

I certify that we will comply with K.S.A. 55-101, et seq., plus eventually plugging hole to K.C.C. specifications.

Date 11-15-84..... Signature of Operator or Agent

Vern Brungardt

Title Manager.....

MHC/KOHE 11/15/84

Must be filed with the K.C.C. five (5) days prior to commencing well
 This card void if drilling not started within six (6) months of date received by K.C.C.

CONSERVATION DIVISION
 Wichita, Kansas

11-15-84


Important procedures to follow:

A Regular Section of Land

1 Mile = 5,280 Feet

NOV 15 1984

1. Notify District office before setting surface casing.
2. Set surface casing by circulating cement to the top.
3. File completion forms ACO-1 with K.C.C. within 90 days of well completion, following instructions on ACO-1, side 1, and including copies of wireline logs.
4. Notify District office 48 hours prior to old well workover or re-entry.
5. Prior to plugging, prepare a plugging plan, then obtain agreement from the appropriate district office for an approved plugging plan.
6. Submit plugging report (CP-4) to K.C.C. after plugging is completed.
7. Obtain an approved injection docket number before disposing of salt water.
8. Notify K.C.C. within 10 days when injection commences or terminates.
9. If an alternate 2 completion, cement in the production pipe from below any usable water to surface within 120 days of spud date.

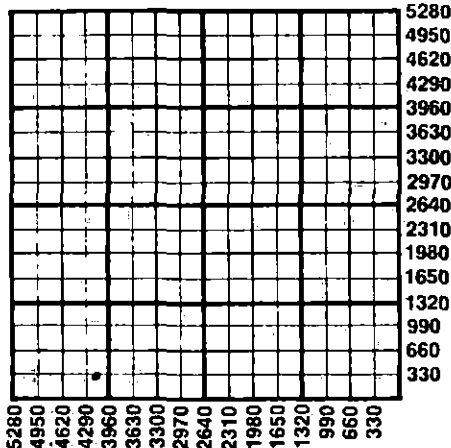

State Corporation Commission of Kansas
 Conservation Division
 200 Colorado Derby Building
 Wichita, Kansas 67202
 (316) 263-3238