

CARD MUST BE TYPED

State of Kansas  
**NOTICE OF INTENTION TO DRILL**  
(see rules on reverse side)

15-185-21207-001

CARD MUST BE SIGNED

*CANCELLED*

Starting Date: November 20 84  
month day year

API Number 15-185-21207-A 12-10-84  
 East

OPERATOR: License # 9963  
Name CRUDE RECOVERY CORPORATION  
Address 555 N. Woodlawn, Bldg. 1, Ste. 207  
City/State/Zip Wichita, KS 67208  
Contact Person Vern Brungardt  
Phone 681-3601

1/2-SW (location) Sec. 6 Twp 22. S, Rge. 12.  West

1320 Ft North from Southeast Corner of Section  
4220 Ft West from Southeast Corner of Section  
(Note: Locate well on Section Plat on reverse side)

CONTRACTOR: License # Unknown  
Name  
City/State

Nearest lease or unit boundary line 660 feet.  
County Stafford  
Lease Name Krankenberg Well# 2

Well Drilled For: Well Class: Type Equipment:  
 Oil  Swd  Infield  Mud Rotary  
 Gas  Inj  Pool Ext.  Air Rotary  
 OWWO  Expl  Wildcat  Cable

Domestic well within 330 feet:  yes  no  
Municipal well within one mile:  yes  no

If OWWO: old well info as follows:  
Operator Energy Reserves Grp. Inc.  
Well Name 1 Geisler  
Comp Date 1/21/81 Old Total Depth 3745  
Projected Total Depth 3760 feet  
Projected Formation at TD Arbuckle  
Expected Producing Formations

Depth to Bottom of fresh water 110 MHC feet  
Lowest usable water formation Top Permian  
Depth to Bottom of usable water 250 feet  
Surface pipe by Alternate: 1  2   
Surface pipe set 699 feet  
Conductor pipe if any required feet  
Ground surface elevation feet MSL  
This Authorization Expires 5-15-85  
Approved By 11-15-84 R

I certify that we will comply with K.S.A. 55-101, et seq., plus eventually plugging hole to K.C.C. specifications.

Date 11-15-84 Signature of Operator or Agent

*Vern Brungardt* Title Manager

MHC/NOHE 11/15/84 Form C-1 4/84

Must be filed with the K.C.C. five (5) days prior to commencing well  
This card void if drilling not started within six (6) months of date received by K.C.C.

11-15-84

CONSERVATION DIVISION  
Wichita, Kansas

Important procedures to follow:

A Regular Section of Land  
1 Mile = 5,280 Ft.

NOV 4 5 1984

Notify District office before setting surface casing.

2. Set surface casing by circulating cement to the top.

3. File completion forms ACO-1 with K.C.C. within 90 days of well completion, following instructions on ACO-1, side 1, and including copies of wireline logs.

4. Notify District office 48 hours prior to old well workover or re-entry.


5. Prior to plugging, prepare a plugging plan, then obtain agreement from the appropriate district office for an approved plugging plan.

6. Submit plugging report (CP-4) to K.C.C. after plugging is completed.

7. Obtain an approved injection docket number before disposing of salt water.

8. Notify K.C.C. within 10 days when injection commences or terminates.

9. If an alternate 2 completion, cement in the production pipe from below any usable water to surface within 120 days of spud date.

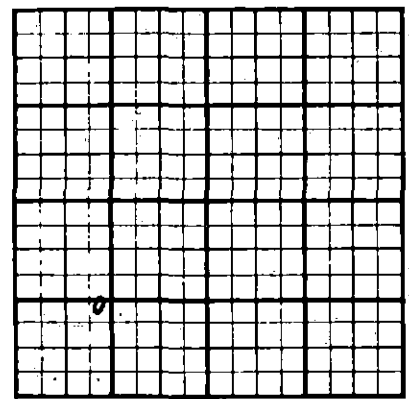

RECEIVED  
STATE CORPORATION COMMISSION

State Corporation Commission of Kansas  
Conservation Division  
200 Colorado Derby Building  
Wichita, Kansas 67202  
(316) 263-3238