

CARD MUST BE TYPED

State of Kansas  
**NOTICE OF INTENTION TO DRILL**

(see rules on reverse side)

*Corrected*  
CARD MUST BE SIGNED

Starting Date: Sept. 13 1984  
month day year

\*\*\*

API Number 15- 185-22,088-0000

100' N & 100' W  
SW NE NE Sec 10 Twp 22 S, Rge 12  East  
(location)  West

OPERATOR: License # 6039

\* 4390 Ft North from Southeast Corner of Section  
\* 1090 Ft West from Southeast Corner of Section  
(Note: Locate well on Section Plat on reverse side)

Name L. D. Drilling, Inc.  
Address P. O. Box 183 B  
City/State/Zip Great Bend, KS 67530  
Contact Person L. D. Davis  
Phone 316-793-3051

CONTRACTOR: License # Our Rig License 517

Name L. D. Drilling, Inc.  
City/State Great Bend, KS

Nearest lease or unit boundary line: 890 feet.  
County STAFFORD  
Lease Name AHNERT Well# 2

Well Drilled For: Well Class: Type Equipment:

- |   |                               |                                    |                                     |
|---|-------------------------------|------------------------------------|-------------------------------------|
| <input checked="" type="checkbox"/> Oil | <input type="checkbox"/> Swd  | <input type="checkbox"/> Infield   | <input type="checkbox"/> Mud Rotary |
| <input type="checkbox"/> Gas            | <input type="checkbox"/> Inj  | <input type="checkbox"/> Pool Ext. | <input type="checkbox"/> Air Rotary |
| <input type="checkbox"/> OWWO           | <input type="checkbox"/> Expl | <input type="checkbox"/> Wildcat   | <input type="checkbox"/> Cable      |

Domestic well within 330 feet:  yes  no  
Municipal well within one mile:  yes  no

If OWWO: old well info as follows:

Depth to Bottom of fresh water 125 feet  
Lowest usable water formation DAKOTA  
Depth to Bottom of usable water 250 feet  
Surface pipe by Alternate: 1  2   
Surface pipe to be set 320 feet  
Conductor pipe if any required None feet  
Ground surface elevation 1850' estimate feet MSL.  
This Authorization Expires 3-11-85  
Approved By 9-11-84

Operator .....

Well Name .....

Comp Date ..... Old Total Depth .....

Projected Total Depth 3650 feet

Projected Formation at TD Arbuckle

Expected Producing Formations LKC-Arbuckle

I certify that we will comply with K.S.A. 55-101, et seq., plus eventually plugging hole to K.C.C. specifications.

*was* 4620 FSL 1500 FEL

Date 9-13-84 Signature of Operator or Agent L. D. Davis Title Operator

\*\*Was 150'E E/2 NW NE


L. D. Davis

\*\*CORRECTED INTENT\*

Must be filed with the K.C.C. five (5) days prior to commencing well  
 This card void if drilling not started within six (6) months of date received by K.C.C.

**Important procedures to follow:**

**A Regular Section of Land  
 1 Mile = 5,280 Ft.**

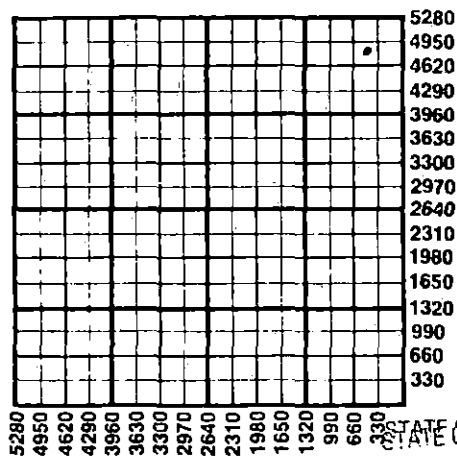

1. Notify District office before setting surface casing.
2. Set surface casing by circulating cement to the top.
3. File completion forms ACO-1 with K.C.C. within 90 days of well completion, following instructions on ACO-1, side 1, and including copies of wireline logs.
4. Notify District office 48 hours prior to old well workover or re-entry.
5. Prior to plugging, prepare a plugging plan, then obtain agreement from the appropriate district office for an approved plugging plan.
6. Submit plugging report (CP-4) to K.C.C. after plugging is completed.
7. Obtain an approved injection docket number before disposing of salt water.
8. Notify K.C.C. within 10 days when injection commences or terminates.
9. If an alternate 2 completion, cement in the production pipe from below by usable water to surface within 120 days of spud date.

RECEIVED  
 STATE CORPORATION COMMISSION

SEP 14 1984

CONSERVATION DIVISION  
 Wichita, Kansas

State Corporation Commission of Kansas  
 Conservation Division  
 200 Colorado Derby Building  
 Wichita, Kansas 67202  
 (316) 263-3238