

CARD MUST BE TYPED

State of Kansas

15,185.22370-0000

CARD MUST BE SIGNED

NOTICE OF INTENTION TO DRILL

(see rules on reverse side)

Starting Date 4 25 86 month day year 257

API Number 15-185-22,370

OPERATOR: License # 6588

NW SW SE Sec. 16 Twp. 22 S, Rg. 12 East West

Name Woodman-Iannitti Oil Company

Address 704 Union Center Building

City/State/Zip Wichita, Kansas 67202

Contact Person K.T. Woodman

Phone (316) 265-7650

990 Ft. from South Line of Section

2310 Ft. from East Line of Section

(Note: Locate well on Section Plat on reverse side)

CONTRACTOR: License # 5122

Name Woodman-Iannitti Oil Company

City/State Wichita, Kansas

Nearest lease or unit boundary line 330 feet

County Stafford

Lease Name Spangenberg Well # 3

Ground surface elevation feet MSL

Domestic well within 330 feet: yes X no

Municipal well within one mile: yes X no

Well Drilled For: Well Class: Type Equipment:

X Oil SWD X Infield X Mud Rotary

Gas Inj Pool Ext Air Rotary

OWWO Expl Wildcat Cable

Depth to bottom of fresh water 110

Depth to bottom of usable water 240

Surface pipe by Alternate: 1 X 2

Surface pipe planned to be set 290'

Conductor pipe required

Projected Total Depth 3696 feet

Formation Arbuckle

If OWWO: old well info as follows:

Operator

Well Name

Comp Date Old Total Depth

I certify that well will comply with K.S.A. 55-101, et seq., plus eventually plugging hole to KCC specifications.

Date 4-21-86 Signature of Operator or Agent K.T. Woodman Title Partner

For KCC Use:

Conductor Pipe Required feet; Minimum Surface Pipe Required 240 feet per Alt. 1

This Authorization Expires 10-21-86 Approved By 4-21-86


20A/KOHK

Must be filed with the K.C.C. five (5) days prior to commencing well  
This card void if drilling not started within six (6) months of date received by K.C.C.

**Important procedures to follow:**

1. Notify District office before setting surface casing.
2. Set surface casing by circulating cement to the top.
3. File completion forms ACO-1 with K.C.C. within 90 days of well completion, following instructions on ACO-1, side 1, and including copies of wireline logs.
4. Notify District office 48 hours prior to old well workover or re-entry.
5. Prior to filing Intent, prepare a proposed plugging plan in case well is D & A, then obtain approval of plan when calling district office prior to setting surface pipe.
6. Submit plugging report (CP-4) to K.C.C. after plugging is completed.
7. Obtain an approved injection docket number before disposing of salt water.
8. Notify K.C.C. within 10 days when injection commences or terminates.
9. If an alternate 2 completion, cement in the production pipe from below any usable water to surface within 120 days of spud date.

**A Regular Section of Land**  
**1 Mile = 5,280 Ft.**

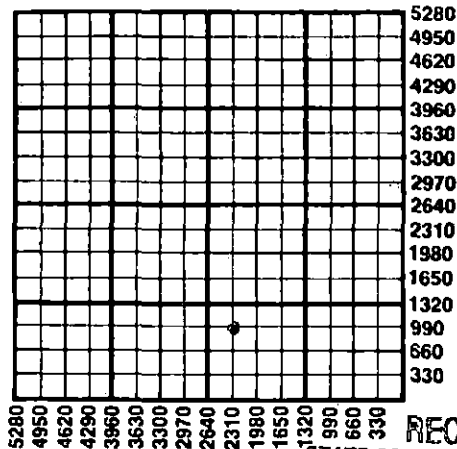

RECEIVED  
STATE CORPORATION COMMISSION

APR 21 1986

CONSERVATION DIVISION  
Wichita, Kansas

4-21-86

State Corporation Commission of Kansas  
Conservation Division  
200 Colorado Derby Building  
Wichita, Kansas 67202  
(316) 263-3238